

STATE OF KANSAS
STATE CORPORATION COMMISSION


WELL PLUGGING RECORD

Give ALL Information Completely
Make Required Affidavit
Mail or Deliver Report to:
Conservation Division
State Corporation Commission
800 Bitting Building
Wichita, Kansas

OR
FORMATION PLUGGING RECORD

Strike out upper line
when reporting plugging
off formations.

Reno County. Sec. 17 Twp. 26S Rge. (E) 4 (W)
Location as "NE 1/4 NW 1/4 SW 1/4" or footage from lines SE/c NE NE
Lease Owner Magnolia Petroleum Company
Lease Name M. Thome Well No. 2
Office Address RFD 1, Ellinwood, Kansas
Character of Well (completed as Oil, Gas or Dry Hole) Oil well
Date well completed 10/8/1937 19
Application for plugging filed 11/5/45 19
Application for plugging approved 11/8/45 19
Plugging commenced 1/3/46 19
Plugging completed 1/8/46 19
Reason for abandonment of well or producing formation Oil production exhausted

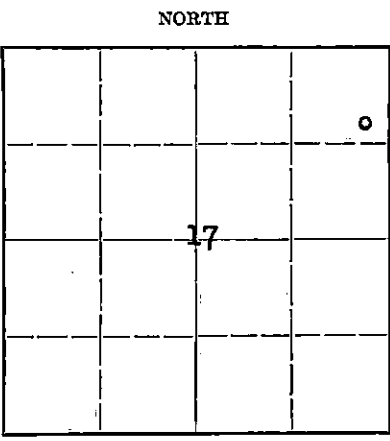

Locate well correctly on above
Section Plat

If a producing well is abandoned, date of last production 10/31/45 19
Was permission obtained from the Conservation Division or its agents before plugging was commenced? Yes

Name of Conservation Agent who supervised plugging of this well Ruel Durkee
Producing formation Viola Lime Depth to top 4021 Bottom 4023 Total Depth of Well 4023 Feet
Show depth and thickness of all water, oil and gas formations.

OIL, GAS OR WATER RECORDS


CASING RECORD

Formation	Content	From	To	Size	Put In	Pulled Out
Viola Lime	Oil & Water	4021	4023	13" OD	222	None
				7" OD	4006	2828

Describe in detail the manner in which the well was plugged, indicating where the mud fluid was placed and the method or methods used in introducing it into the hole. If cement or other plugs were used, state the character of same and depth placed, from _____ feet to _____ feet for each plug set.

Cemented bottom of hole w/6 sax cement from 4023 to 3993 + 2868
Shot 7" Csg. at 2969 - 2938 @ 2901 - 2848' & pulled out
Filled w/heavy mud with hand shovels and slips from 3993 to 215
Set bridge and cemented w/25 sax cement from 215 to 182
Filled w/heavy mud with hand shovels and slips from 182 to 16
Cemented w/8 sax cement from 16 to 6 or bottom of cellar
Filled cellar with soil to ground level.

PLUGGING
FILE 17 26S 4W
BOOK PAGE 32 LINE 23

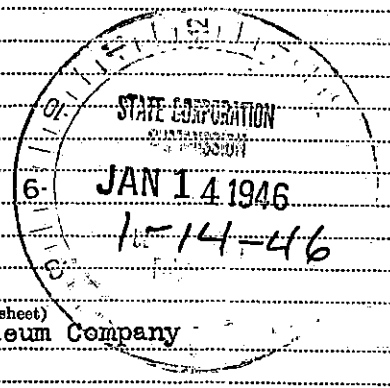

(If additional description is necessary, use BACK of this sheet)
Correspondence regarding this well should be addressed to Magnolia Petroleum Company
Address RFD 1, Ellinwood, Kansas

STATE OF Kansas, COUNTY OF Barton, ss.
C. A. Hill (employee of owner) or (superintendent) of the above-described well,

being first duly sworn on oath, says: That I have knowledge of the facts, statements, and matters herein contained and the log of the above-described well as filed and that the same are true and correct. So help me God.

(Signature) *C. A. Hill*
RFD 1, Ellinwood, Kansas
(Address)

SUBSCRIBED AND SWORN to before me this 11th day of January 19 46

My commission expires November 30, 1949

[Signature]
Notary Public.

MAGNOLIA PETROLEUM COMPANY

A SOCONY-VACUUM COMPANY

PRODUCING DIVISION

Drlg. Comm. 9/11/37
 Drlg. Comp. 10/8/37
 Plugging Comm. 1/3/46
 Plugging Comp. 1/5/46

Magnolia Petroleum Company
 M. Thome P.I. #2
 SE/c NE NE Section 17-26S-4W.
 Reno County, Kansas

Casing Record

13"OD put in 222' pulled out 0
 7"OD put in 4006' pulled 2828'

Cellar	0	10
red bed & sand	10	165
shale & shells	165	229
13"OD Csg. set	222	
shale	229	400
salt	400	650
shale & lime	650	925
shale & shells	925	1000
sand & lime	1000	1100
shale & lime	1100	1270
lime & shale	1270	1420
shale & shells	1420	1555
shale	1555	1760
shale & shells	1760	1950
lime & shale	1950	2125
shale & shells	2125	2610
shale & lime	2610	2865
lime	2865	3045
shale	3045	3055
lime	3055	3520
shale	3520	3606
chat	3606	3640
lime	3640	3880
shale & lime	3880	3905
shale & shells	3905	3945
shale & lime	3945	3981
Top Sylvan Shale	3981	4006
Misner Sand - Top	3980	
7" OD Csg. set	4006	

Standardized

Shale - cored	4006	4021
Top Viola Lime	4021	
Viola Lime - cored	4021	4023
TD-SLM	4023'	

PLUGGING
 FILL 17 26 4W
 EOOK 32 23

