


STATE OF KANSAS
STATE CORPORATION COMMISSION

WELL PLUGGING RECORD

Give All Information Completely
Make Required Affidavit
Mail or Deliver Report to:
Conservation Division
State Corporation Commission
212 North Market, Insurance Bldg.
Wichita, Kansas

RENO County. Sec. 14 Twp. 26S Rge. 4 WEST (W)
Location as "NE/CNW/SW" or footage from lines CENTER NW/4 SE/4
Lease Owner REX & MORRIS DRILLING COMPANY, ET AL
Lease Name BOGNER Well No. 1
Office Address P. O. BOX 334, EL DORADO, KANSAS
Character of Well (completed as Oil, Gas or Dry Hole) DRY HOLE
Date well completed 4 MARCH 19 61
Application for plugging filed 4 MARCH 19 61
Application for plugging approved 4 MARCH 19 61
Plugging commenced 4 MARCH 19 61
Plugging completed 4 MARCH 19 61
Reason for abandonment of well or producing formation DRY HOLE

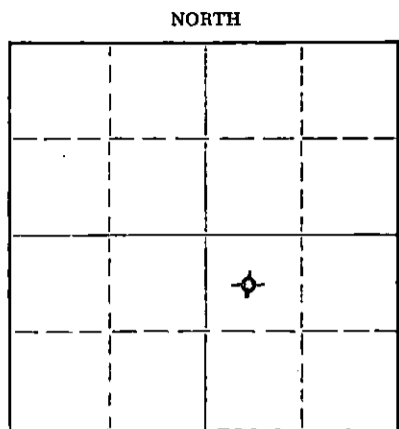

Locate well correctly on above
Section Plat

If a producing well is abandoned, date of last production NONE 19
Was permission obtained from the Conservation Division or its agents before plugging was commenced? YES

Name of Conservation Agent who supervised plugging of this well FRED W. HAMPEL
Producing formation NONE Depth to top Bottom Total Depth of Well 3800 Feet
Show depth and thickness of all water, oil and gas formations.

OIL, GAS OR WATER RECORDS

CASING RECORD

FORMATION	CONTENT	FROM	TO	SIZE	PUT IN	PULLED OUT
SURFACE HOLE	WATER	SURFACE	241' RB	8 5/8" OD	235.02'	LEFT IN
(SEE ATTACHED LOG)						

Describe in detail the manner in which the well was plugged, indicating where the mud fluid was placed and the method or methods used in introducing it into the hole. If cement or other plugs were used, state the character of same and depth placed, from feet to feet for each plug set.

FILLED HOLE WITH DRILLING MUD TO 250', SET PLUG AND CEMENTED WITH 15 SACKS CEMENT, FILLED HOLE WITH MUD TO 35', SET PLUG AND CEMENTED WITH 10 SACKS CEMENT, PUT 2 SACKS CEMENT IN RAT HOLE.

RECEIVED
STATE CORPORATION COMMISSION
4-5-61
APR 5 1961
CONSERVATION DIVISION
Wichita, Kansas

(If additional description is necessary, use BACK of this sheet)
Name of Plugging Contractor REX & MORRIS DRILLING COMPANY
Address P. O. BOX 334, EL DORADO, KANSAS

STATE OF KANSAS, COUNTY OF BUTLER, ss.
A. H. FISHER (employee of owner) or (owner or operator) of the above-described well, being first duly sworn on oath, says: That I have knowledge of the facts, statements, and matters herein contained and the log of the above-described well as filed and that the same are true and correct. So help me God.

(Signature) A. H. Fisher
P. O. BOX 334, EL DORADO, KANSAS
(Address)

SUBSCRIBED AND SWORN TO before me this 3RD day of APRIL, 19 61

My commission expires 8 AUGUST 1962
ELIZABETH DESCHNER Notary Public.

15-155-00209-0000

Elevation 1546 R. B.
1543 D. F.

BOGNER #1

Total Depth:	3800	Location: — C. NW SE
Contractor:	Rex & Morris Drilling Co.	Section 14-26S-4W
Commenced:	2-22-61	Reno County, Kansas
Completed:	3-4-61	Casing Record:
Initial Prod.:	D. & A.	8 5/8 @ 241' w/200 sacks

FORMATION	DEPTH
Surface Hole	241
Shale	840
Lime and Shale	1305
Shale and Lime	2225
Shale	2296
Lime	2405
Lime and Shale	2546
Shale and Lime	2915
Lime	3575
Lime and Shale	3645
Shale and Lime	3697
Lime (Miss.)	T.D. 3800

Ran Schlumberger GR, LL, MLL

RECEIVED
STATE CORPORATION COMMISSION
4-5-61
APR 5 1961

CONSERVATION DIVISION
Wichita, Kansas

I hereby certify the foregoing statements are true and correct to the best of my knowledge and belief.

Rex & Morris Drilling Company

By Paul D. Koontz
Paul D. Koontz, Geologist

STATE OF KANSAS
COUNTY OF BUTLER, SS.

Subscribed and sworn to before me, a Notary Public, this 7th day of March, 1961.

Elizabeth Deschner
Elizabeth Deschner, Notary Public

My commission expires: August 8, 1962.