


STATE OF KANSAS
STATE CORPORATION COMMISSION

WELL PLUGGING RECORD

Give All Information Completely
Make Required Affidavit
Mail or Deliver Report to:
Conservation Division
State Corporation Commission
211 No. Broadway
Wichita, Kansas

Reno County. Sec. 15 Twp. 26S Rge. 4W (E) (W)
Location as "NE/CNW%SW%" or footage from lines C NW/4 SE/4
Lease Owner Walters Drilling Co.
Lease Name Brox Well No. 1
Office Address 510 Orpheum Building, Wichita 2, Kansas
Character of Well (completed as Oil, Gas or Dry Hole) Dry Hole
Date well completed June 23rd 1962
Application for plugging filed June 23rd 1962
Application for plugging approved June 23rd 1962
Plugging commenced June 24th 1962
Plugging completed June 24th 1962
Reason for abandonment of well or producing formation _____

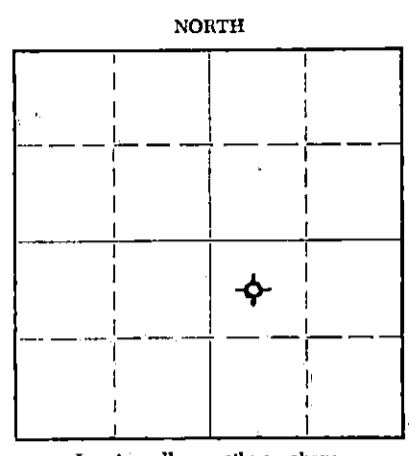

Locate well correctly on above
Section Plat

If a producing well is abandoned, date of last production _____ 19____
Was permission obtained from the Conservation Division or its agents before plugging was commenced? Yes

Name of Conservation Agent who supervised plugging of this well Herman Justice
Producing formation Simpson Depth to top _____ Bottom _____ Total Depth of Well 4200 Feet
Show depth and thickness of all water, oil and gas formations.

OIL, GAS OR WATER RECORDS

CASING RECORD

FORMATION	CONTENT	FROM	TO	SIZE	PUT IN	PULLED OUT
				8-5/8"	106'	-0-

Describe in detail the manner in which the well was plugged, indicating where the mud fluid was placed and the method or methods used in introducing it into the hole. If cement or other plugs were used, state the character of same and depth placed, from _____ feet to _____ feet for each plug set.

Set bottom plug at 100 ft. with hulls and 20 sacks cement through drill pipe. Set top plug at 40 ft. with hulls and 10 sacks cement to collar in cellar. Plug and cement rat hole.

RECEIVED
STATE CORPORATION COMMISSION
JUN 27 1962
6-27-62
CONSERVATION DIVISION
Wichita, Kansas

(If additional description is necessary, use BACK of this sheet)
Name of Plugging Contractor Walters Drilling Co.
Address 510 Orpheum Building, Wichita, Kansas

STATE OF KANSAS, COUNTY OF Sedgwick, ss.
Robert F. Walters (employee of owner) or (owner or operator) of the above-described well, being first duly sworn on oath, says: That I have knowledge of the facts, statements, and matters herein contained and the log of the above-described well as filed and that the same are true and correct. So help me God.

(Signature) Robert F. Walters
ROBERT F. WALTERS, Partner
510 Orpheum Building, Wichita 2, Kansas
(Address)

SUBSCRIBED AND SWORN to before me this 26th day of June 1962

R. L. Abel
R. L. Abel
Notary Public.

My commission expires January 4th, 1964

BROX #1

LOCATION: C NW/4 SE/4 Section 15-26S-4W
Reno County, Kansas

OPERATOR: Walters Drilling Co.

CONTRACTOR: Walters Drilling Co.

SURFACE CASING: 8-5/8" set @ 106' with 80 sacks cement

OIL STRING: None

DATE SPUDDED: June 11, 1962

ROTARY COMPLETION: June 23, 1962

ELEVATION: 1552 GL
1554 DF
1557 KB

L O G
(Figures indicate bottom of formation)

Shale, Shells & Red Bed	325'
Shale & Shells	820'
Shale & Lime	1275'
Lime	1460'
Lime & Shale	2668'
Sand & Shale	2916'
Lime	3245'
Lime & Shale	3305'
Lime	3338'
Lime & Shale	3737'
Lime & Chert	3820'
Lime	4055'
Shale	4145'
Shale & Sand	4200'
Total Depth	4200'

RECEIVED
STATE CORPORATION COMMISSION
6-27-62
JUN 27 1962
CONSERVATION DIVISION
Wichita, Kansas

The undersigned, Robert F. Walters, hereby certifies that the above log is a true and correct log of the formations encountered in drilling the above noted well as reflected by the Daily Drilling Reports.

WALTERS DRILLING CO.

By

Robert F. Walters

ROBERT F. WALTERS, Partner

Subscribed and sworn to before me
this 26th day of June, 1962.

R. L. Abel
R. L. Abel, Notary Public

My commission expires January 4th, 1964