


STATE OF KANSAS
STATE CORPORATION COMMISSION

WELL PLUGGING RECORD

Give All Information Completely
Make Required Affidavit
Mail or Deliver Report to:
Conservation Division
State Corporation Commission
800 Biting Building
Wichita, Kansas

Reno County. Sec. 23 Twp. 26 Rge. 5 (E) (W)
Location as "NE/CNW/SW" or footage from lines _____
Lease Owner Trans Era Petroleum, Inc.
Lease Name Blocker Well No. #1
Office Address Russell, Kansas
Character of Well (completed as Oil, Gas or Dry Hole) Dry Hole
Date well completed 5/23/53 19____
Application for plugging filed May 27, 1953 19____
Application for plugging approved _____ 19____
Plugging commenced May 22, 1953 19____
Plugging completed May 22, 1953 19____
Reason for abandonment of well or producing formation dry hole

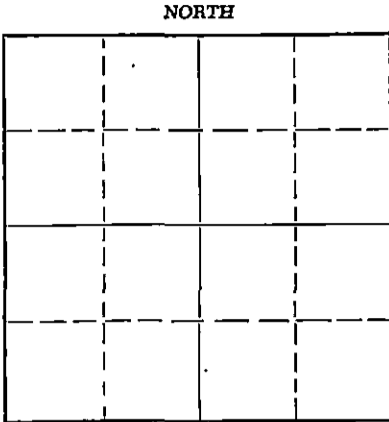

Locate well correctly on above
Section Plat

If a producing well is abandoned, date of last production _____ 19____
Was permission obtained from the Conservation Division or its agents before plugging was commenced? yes

Name of Conservation Agent who supervised plugging of this well Ruel Durkee
Producing formation _____ Depth to top _____ Bottom _____ Total Depth of Well 4155 Feet
Show depth and thickness of all water, oil and gas formations.

OIL, GAS OR WATER RECORDS

CASING RECORD

FORMATION	CONTENT	FROM	TO	SIZE	PUT IN	PULLED OUT
				8 5/8"	225'	None

Describe in detail the manner in which the well was plugged, indicating where the mud fluid was placed and the method or methods used in introducing it into the hole. If cement or other plugs were used, state the character of same and depth placed, from _____ feet to _____ feet for each plug set.

PLUGGING RECORD

Filled hole with heavy mud to 220' set first plug. Ran 20 sacks of cement
Filled hole with mud to 20' set second plug with 5 sacks of cement.

(If additional description is necessary, use BACK of this sheet)

Name of Plugging Contractor _____
Address _____

STATE OF KANSAS, COUNTY OF RUSSELL, ss.
Herbert R. Michaelis (employee of owner) or (owner/operator) of the above-described well, being first duly sworn on oath, says: That I have knowledge of the facts, statements, and matters herein contained and the log of the above-described well as filed and that the same are true and correct. So help me God.

(Signature) H. R. Michaelis
Russell, Kansas
(Address)

SUBSCRIBED AND SWORN to before me this 27th day of May, 19 53

Margie Cooper
Notary Public.

My commission expires January 30, 1957

RECEIVED
STATE CORPORATION COMMISSION
MAY 28 1953
5-28-53
CONSERVATION DIVISION
Wichita, Kansas

24-7368-B 3-53-20M

PLUGGING
FILE SEC 23 T 26 R 5W
BOOK PAGE 104 LINE 8

Trans Era Petroleum, Inc.
Blocker #1

NE NE SE 23-26-5
Reno County, Kansas

Total Depth: 4155'
Comm: 4/28/53
Comp: 5/23/53

Casing

8 5/8" Set @ 225'

Cement

150 sacks Pozmix

Formation

Depth

Shale - sand	60
Shale - shells	225
Anhydrite	230
Shale - shells	430
Salt - shale	650
Shale - shells	670
Shale - lime shells	930
Shale - shells	960
Lime - shale	1250
Lime	1290
Lime - shale	1635
Lime shells - shale	2035
Lime - shale	2670
Lime	2700
Lime - shale	2730
Shale	2800
Lime - shale	2905
K. C. Lime	2950
Lime	2994
Lime - shale	3033
Lime	3270
Lime - shale	3350
Lime	3387
Lime - shale	3585
Mississippi Chert	3607
Mississippi	3622
Chert - shale	3727
Chert	3741
Chert - shale	3774
Chert	3788
Chert - shale	3809
Lime - chert	3863
Shale	4002
Viola	4012
Viola Lime	4021
Simpson sand	4031
Sand - lime	4045
Simpson sand	4063
Sand - shale	4129
Arbuckle lime	4155'

STATE OF KANSAS)
) ss.
RUSSELL COUNTY)

PLUGGING
FILE SEC 23 T 26 R 5W
BOOK PAGE 104 LINE 8

I hereby certify that the above information is true and correct to the best of my knowledge.

Louis Hanson

Subscribed and sworn to before me this 27th day of May, 1953.

STATE COM. PL.

5-28-53 Maigie Cooper
Notary Public Russell County, Ks.

My Commission expires:
January 30, 1957