


STATE OF KANSAS
STATE CORPORATION COMMISSION

WELL PLUGGING RECORD

Give All Information Completely
Make Required Affidavit
Mail or Deliver Report to:
Conservation Division
State Corporation Commission
211 No. Broadway
Wichita, Kansas

NORTH

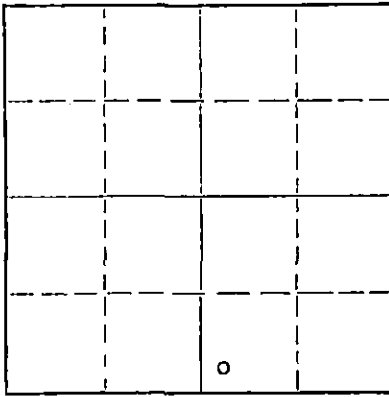

Locate well correctly on above
Section Plat

Reno County, Sec. 23 Twp. 26S Rge. 5 (E) ~~W~~
Location as "NE/CNW/SW" or footage from lines SW/4 SW/4 SE/4
Lease Owner Twin Drilling, Inc.
Lease Name Blocker Well No. 1
Office Address 1005 Central Building, Wichita, Kansas
Character of Well (completed as Oil, Gas or Dry Hole) Dry Hole
Date well completed 12-6 19 58
Application for plugging filed 12-11 19 58
Application for plugging approved 12-12 19 58
Plugging commenced 12-6 19 58
Plugging completed 12-6 19 58
Reason for abandonment of well or producing formation Dry Hole

If a producing well is abandoned, date of last production 19
Was permission obtained from the Conservation Division or its agents before plugging was commenced? Yes

Name of Conservation Agent who supervised plugging of this well Fred Hampel, Pretty Prairie, Kansas
Producing formation Depth to top Bottom Total Depth of Well 4032' Feet
Show depth and thickness of all water, oil and gas formations.

OIL, GAS OR WATER RECORDS

CASING RECORD

FORMATION	CONTENT	FROM	TO	SIZE	PUT IN	PULLED OUT
				8 5/8	286.71	

Describe in detail the manner in which the well was plugged, indicating where the mud fluid was placed and the method or methods used in introducing it into the hole. If cement or other plugs were used, state the character of same and depth placed, from feet to feet for each plug set.

Filled hole with rotary mud to 240'
Set plug and cement through drill pipe W/20 sacks cement
Fill hole up to 35' of base of cellar and set plug
Cap with 10 sacks cement

RECEIVED
STATE CORPORATION COMMISSION
DEC 18 1958
CONSERVATION DIVISION
Wichita, Kansas

(If additional description is necessary, use BACK of this sheet)
Name of Plugging Contractor Twin Drilling, Inc.
Address 1005 Central Building, Wichita, Kansas

STATE OF KANSAS, COUNTY OF SEDGWICK, ss.
C. R. Dunne (employee of owner) or (owner or operator) of the above-described well, being first duly sworn on oath, says: That I have knowledge of the facts, statements, and matters herein contained and the log of the above-described well as filed and that the same are true and correct. So help me God.

(Signature) C. R. Dunne
Wichita, Kansas (Address)

SUBSCRIBED AND SWORN TO before me this 17 day of December, 19 58

My commission expires Sept. 9, 1961

Notary Public.

PLUGGING
FILE SEC 23 T 26 R SW
BOOK PAGE 3 LINE 31

WELL LOG

Well: Blocker #1
Location: SW/4 SW/4 SE/4
Section 23-26S-5W
Reno County, Kansas

Contractor & Operator:
Twin Drilling, Inc.
1005 Central Building
Wichita, Kansas

Elevation: 1406 D.F.

Commenced: 11-21-58
Completed: 12-6-58

Casing: 8 5/8" - 286.71'
W/175 Sx - 2% C.C. - 2% Gel.

Surface	110
Shale-Shells	207
Shale-Lime	283
Shale-Shells	675
Shale-Lime	1000
Lime	1340
Shale-Lime Streaks	1560
Shale-Lime	2170
Lime-Shale Breaks	2290
Lime	2435
Lime-Shale	2844
Lime	3104
Shale-Lime	3168
Lime	3240
Lime-Shale	3563
Lime	3668
Chert	3690
Lime-Chert	3789
Lime	3813
Chert-Lime	3848
Shale	3910
Shale & Sand	3953

Shale-Lime	4005
Sand	4032
T.D.	4032'

Tops:
Lansing 2831'
Mississippi 3562'
Hainer 3920'
Viola 3984'

STATE OF KANSAS)
) ss.
COUNTY OF SEDGWICK)

The undersigned, TWIN DRILLING, INC., hereby certifies that the above log is a true and correct log of the formations encountered in drilling the above well as reflected by the Daily Drilling Report.

TWIN DRILLING, INC.

By Alma L. Day

Subscribed and sworn to before me
this 11th day of December, 1958.

James A. White
Notary Public

My commission expires
September 29, 1960.

RECEIVED
STATE CORPORATION COMMISSION
12-12-58
DEC 12 1958

CONSERVATION DIVISION
Wichita, Kansas

PLUGGING
FILE SEC 23 T 26 R 5W
BOOK PAGE 3 LINE 31