

STATE CORPORATION COMMISSION OF KANSAS
OIL & GAS CONSERVATION DIVISION
WELL COMPLETION FORM
ACO-1 WELL HISTORY
DESCRIPTION OF WELL AND LEASE


Operator: License # 5046
Name: Raymond Oil Company, Inc.
Address P.O. Box 48788
City/State/Zip Wichita, KS 67201
Purchaser: _____
Operator Contact Person: Pat Raymond
Phone (316) 267-4214
Contractor: Name: Lobo Drilling Company
License: 5864
Wellsite Geologist: _____

Designate Type of Completion
 New Well Re-Entry Workover
 Oil SWD Temp. Abd.
 Gas Inj Delayed Comp.
 Dry Other (Core, Water Supply, etc.)

If OWWO: old well info as follows:
Operator: _____
Well Name: _____
Comp. Date _____ Old Total Depth _____

Drilling Method:
 Mud Rotary Air Rotary Cable
08-14-90 08-20-90 8-30-90
Spud Date Date Reached TD Completion Date

API NO. 15- 185-22,694-0000
County Stafford
SE SE SW Sec. 33 Twp. 25 Rge. 11 East West
330 Ft. North from Southeast Corner of Section
2970 Ft. West from Southeast Corner of Section
(NOTE: Locate well in section plat below.)
Lease Name McCarty Well # 1
Field Name Bäumen
Producing Formation Mississippi
Elevation: Ground 1839 KB 1848
Total Depth 4225' PBDT _____

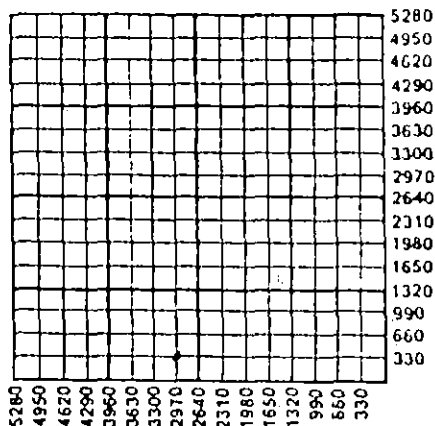

Amount of Surface Pipe Set and Cemented at 255' Feet
Multiple Stage Cementing Collar Used? Yes No
If yes, show depth set _____ Feet
If Alternate II completion, cement circulated from _____
feet depth to _____ w/ _____ sx cmt.

INSTRUCTIONS: This form shall be completed in triplicate and filed with the Kansas Corporation Commission, 200 Colorado Derby Building, Wichita, Kansas 67202, within 120 days of the spud date of any well. Rule 82-3-130, 82-3-107 and 82-3-106 apply. Information on side two of this form will be held confidential for a period of 12 months if requested in writing and submitted with the form. See rule 82-3-107 for confidentiality in excess of 12 months. One copy of all wireline logs and drillers time log shall be attached with this form. ALL CEMENTING TICKETS MUST BE ATTACHED. Submit CP-4 form with all plugged wells. Submit CP-111 form with all temporarily abandoned wells. Any recompletion, workover or conversion of a well requires filing of ACO-2 within 120 days from commencement date of such work.

All requirements of the statutes, rules and regulations promulgated to regulate the oil and gas industry have been fully complied with and the statements herein are complete and correct to the best of my knowledge.

Signature Patrick R. Raymond
Title Vice President Date 09-05-90
Subscribed and sworn to before me this 5th day of September, 19 90.
Notary Public Sharron A. Hill
Date Commission Expires July 28, 1991

K.C.C. OFFICE USE ONLY

F Letter of Confidentiality Attached
C Wireline Log Received
C Drillers Timelog Received

'Distribution

KCC SWD/Rep NGPA
 KGS Plug Other
(Specify)

Sharron A. Hill
NOTARY PUBLIC
State of Kansas
MY APPT. EXPIRES 7-28-91

9-21-90

P1