


STATE OF KANSAS
STATE CORPORATION COMMISSION

Form CP-4

Give All Information Completely
Make Required Affidavit
Mail or Deliver Report to:
Conservation Division
State Corporation Commission
P. O. Box 17027
Wichita, Kansas 67217
NORTH

WELL PLUGGING RECORD

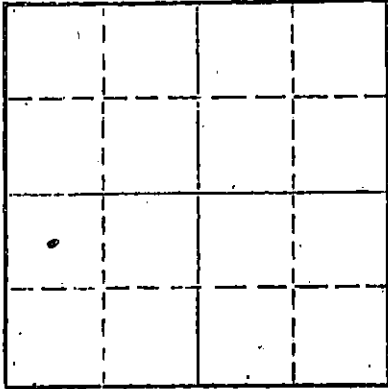

Locate well correctly on above
Section Plat

Reno County, Sec. 12 Twp. 26S Rge. (E) 5 (W)
Location as "NE/CNW/SW" or footage from lines: C NW SW
Lease Owner: Pyramid Corp., Inc.
Lease Name: Theis Well No. 1
Office Address: 3000 W. Kellogg, Wichita, Kansas 67213
Character of Well (completed as Oil, Gas or Dry Hole): oil
Date well completed: 19
Application for plugging filed: Nov. 29 19 73
Application for plugging approved: 19
Plugging commenced: Jan. 7 19 74
Plugging completed: Jan. 23 19 74
Reason for abandonment of well or producing formation: depleted

If a producing well is abandoned, date of last production: 19
Was permission obtained from the Conservation Division or its agents before plugging was commenced? YES

Name of Conservation Agent who supervised plugging of this well: Hugh Scott
Producing formation: Depth to top: Bottom: Total Depth of Well: 4071 Feet
Show depth and thickness of all water, oil and gas formations.

OIL, GAS OR WATER RECORDS

CASING RECORD

FORMATION	CONTENT	FROM	TO	SIZE	PUT IN	PULLED OUT
		0	238'	8 5/8"	238'	none
			4040'	5 1/2"	4040'	3197.31

Describe in detail the manner in which the well was plugged, indicating where the mud fluid was placed and the method or methods used in introducing it into the hole. If cement or other plugs were used, state the character of same and depth placed, from _____ feet to _____ feet for each plug set.

Sanded back to 3550' and dumped 5 sacks of cement.

Allied Cementing Company plugged well pumping in 4 sacks of hulls, 20 sacks of mud and 85 sacks of cement.

RECEIVED
STATE CORPORATION COMMISSION
JAN 31 1974
74
CONSERVATION DIVISION
Wichita, Kansas

Name of Plugging Contractor: PIPE PULLERS, INC.
Address: Box 186, Ellinwood, Kansas 67526

STATE OF KANSAS, COUNTY OF BARTON, ss.
Evelyn Roth (employee of owner) or (owner or operator) of the above-described well, being first duly sworn on oath, says: That I have knowledge of the facts, statements, and matters herein contained and the log of the above-described well as filed and that the same are true and correct. So help me God.

(Signature) Evelyn Roth
Ellinwood, Kansas (Address)

Subscribed and sworn to before me this 29th day of January, 19 74
George A. Meyer Notary Public.
My commission expires Feb. 10, 1975

DRILLERS LOG

No. 1 Theis

CASING RECORD:	COMPANY: Am. Marine Cont. Oil Corp.	DESCRIPTION:
8 5/8" @ 238' w/190 sx cement	CONTRACTOR: Red Tiger Drilling Co.	C NW SW 12-26S-5W Reno County, Kansas
5 1/2" @ 4040.95' w/125 sx cement	COMMENCED: March 22, 1973	
TOTAL DEPTH: 4071'	COMPLETED: April 4, 1973	ELEVATION:

<u>FORMATION</u>	<u>FROM</u>	<u>TO</u>	<u>REMARKS</u>
Rathole	0	35	
Sand	35	45	
Redbed & Shale	45	239	
Shale & Lime Streaks	239	360	
Shale & Shells	360	675	
Lime & Shale Streaks	675	825	
Lime & Shale	825	1165	
Lime & Shale Streaks	1165	1330	
Lime & Shale	1330	1682	
Lime, Shale & Sand	1682	1825	
Lime & Shale	1825	2065	
Shale & Lime Streaks	2065	2226	
Lime	2226	2380	
Lime & Shale	2380	2605	
Koebner	2605	2610	
Lime & Shale	2610	2790	
Base Lime & Shale	2790	2829	
Lansing Kansas City	2829	2877	
Lime	2877	3175	
Lime & Chert	3175	3225	
Lime	3225	3350	
Lime & Shale	3350	3600	
Mississippi	3600	3640	
Cherty Lime	3640	3700	
Lime	3700	3805	
Mississippi	3805	3855	
Lime	3855	3862	
Shale - Kinderhook	3862	3900	
Kinderhook	3900	4071	

RECEIVED
STATE CORPORATION COMMISSION
11-30-73
NOV 30 1973
CONSERVATION DIVISION
Wichita, Kansas

I certify that this is a true and correct copy of the above log to the best of my knowledge.

RED TIGER DRILLING COMPANY

Gloria Fawcett
Gloria Fawcett

Subscribed and sworn to before me this 16th day of April, 1973.

Linda H. Dickens
Notary Public

My Commission Expires:

March 8, 1977

