


STATE OF KANSAS
STATE CORPORATION COMMISSION
Give All Information Completely
Make Required Affidavit
Mail or Deliver Report to:
Conservation Division
State Corporation Commission
800 Bittling Building
Wichita, Kansas

WELL PLUGGING RECORD

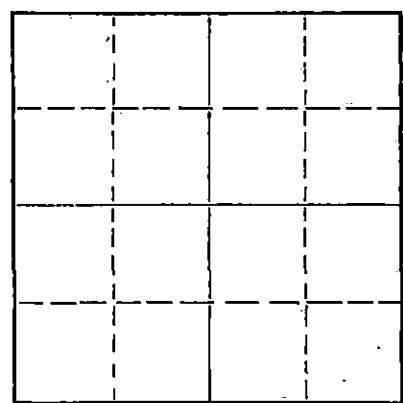

Locate well correctly on above Section Plat

Reno County, Sec. 13 Twp. 26S Rge. 5W (E) W (W)
Location as "NE/CNW/SW" or footage from lines SW SW SE
Lease Owner Trans Era Petroleum, Inc.
Lease Name Bender Well No. 1
Office Address Russell, Kansas
Character of Well (completed as Oil, Gas or Dry Hole) Dry Hole
Date well completed 9/2/54 19
Application for plugging filed 9/1/54 19
Application for plugging approved 9/1/54 19
Plugging commenced 9/2/54 19
Plugging completed 9/2/54 19
Reason for abandonment of well or producing formation Dry Hole

If a producing well is abandoned, date of last production 19
Was permission obtained from the Conservation Division or its agents before plugging was commenced? Yes

Name of Conservation Agent who supervised plugging of this well Ruel Durkee
Producing formation Depth to top Bottom Total Depth of Well 4158 Feet
Show depth and thickness of all water, oil and gas formations.

OIL, GAS OR WATER RECORDS

CASING RECORD

FORMATION	CONTENT	FROM	TO	SIZE	PUT IN	PULLED OUT
				8 5/8"	288'	None

Describe in detail the manner in which the well was plugged, indicating where the mud fluid was placed and the method or methods used in introducing it into the hole. If cement or other plugs were used, state the character of same and depth placed, from feet to feet for each plug set.

PLUGGING RECORD

Layed down drill pipe. Filled hole with heavy mud to 288', set bottom plug at 288', bridged hole at 288', 15 sacks of cement mixed and run through drill pipe on bottom plug. Filled hole with heavy mud to 30', set top plug at 30' with 5 sacks of cement on top plug.

(If additional description is necessary, use BACK of this sheet)

Name of Plugging Contractor Trans Era Petroleum, Inc.
Address Russell, Kansas

STATE OF KANSAS, COUNTY OF RUSSELL, ss.
T. R. Sullivan (employee of owner) or (owner or operator) of the above-described well, being first duly sworn on oath, says: That I have knowledge of the facts, statements, and matters herein contained and the log of the above-described well as filed and that the same are true and correct. So help me God.

(Signature) T.R. Sullivan
Russell, Kansas (Address)

SUBSCRIBED AND SWORN to before me this 9th day of September, 1954

My commission expires 9-9-57
Notary Public
STATE OF KANSAS

PLUGGING
FILE SEC 13 T 26 R 5W
BOOK PAGE 41 LINE 4

9-11-54
CONSERVATION DIVISION
Wichita, Kansas

Trans Era Petroleum, Inc.
Bender #1

SW SW SE 13-26S-5W
Reno County, Kansas

Total Depth 4158'
Comm. 8/10/54
Comp. 9/2/54

Casing

8 5/8" Set @ 288'

Cement

160 sacks of Lehigh

FORMATION	DEPTH
Red bed	40
Clay-sand	75
Shale-shells	288
Shale	480
Salt-shale	780
Lime-shale	2855
Lime	3294
Lime-shale	3600
Miss. Chat	3654
Miss.	3883
Kinderhook Shale	3910
Shale	3953
Kinderhook	4024
Viola	4043
Shale-lime	4132
Arbuckle	4158'

STATE OF KANSAS }
 } ss
RUSSELL COUNTY }

I hereby certify that the above information is true and correct to the best of my knowledge.

Carla B. B...

Subscribed and sworn to before me this 9th day of September, 1954.

Gail S. Thysand
Notary Public

My commission expires: ⁹⁻⁹ ~~2-20~~-57.

9-11-54

PLUGGING
FILE SEC-13T-26R-41
BOOK PAGE 41-42-43-44