


STATE OF KANSAS  
STATE CORPORATION COMMISSION

WELL PLUGGING RECORD

Give All Information Completely  
Make Required Affidavit  
Mail or Deliver Report to  
Conservation Division  
State Corporation Comm.  
245 North Water  
Wichita, KS 67202

Reno County, Sec. 22 Twp. 24S Rge. 5W  
Location as "NE/CNW $\frac{1}{4}$ SW $\frac{1}{4}$ " or footage from lines  
SW SW SE

Lease Owner Oil Properties Co., Inc.  
Lease Name Yoder Well No. 1  
Office Address Box 3335, Andover, Kansas 67002  
Character of Well (Completed as Oil, Gas or Dry Hole)  
Lost Circulation, Skid Rig 12' East.

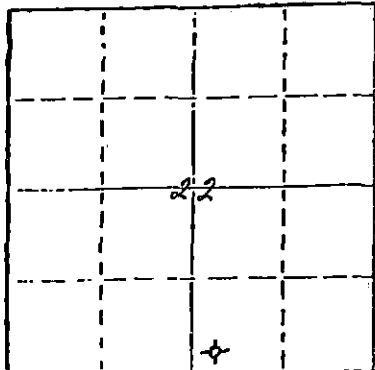

Locate well correctly on above  
Section Plat

Date Well completed July 12, 1980  
Application for plugging filed July 12, 1980  
Application for plugging approved July 12, 1980  
Plugging commenced July 12, 1980  
Plugging completed July 12, 1980  
Reason for abandonment of well or producing formation  
Lost Circulation, Skid Rig 12' East.

If a producing well is abandoned, date of last production 19

Was permission obtained from the Conservation Division or its agents before plugging was commenced? Yes

Name of Conservation Agent who supervised plugging of this well Gilbert Toman  
Producing formation Depth to top Bottom Total Depth of Well 609'  
Show depth and thickness of all water, oil and gas formations.

OIL, GAS OR WATER RECORDS

CASING RECORD

FORMATION	CONTENT	FROM	TO	SIZE	PUT IN	PULLED OUT
		0	291	8-5/8"	284.44'	None

Describe in detail the manner in which the well was plugged, indicating where the mud fluid was placed and the method or methods used in introducing it into the hold. If cement or other plugs were used, state the character of same and depth placed, from feet to feet for each plug set.

Plugged with 50 sacks cement and  
3 sackshulls at 400'; 10 sacks  
Cement and bridge plug at 40';  
5 sacks cement in rat hole.


(If additional description is necessary, use BACK of this form)  
Name of Plugging Contractor Allied Cementing Co.

RECEIVED 8-13-80  
STATE CORPORATION COMMISSION  
AUG 13 1980  
CONSERVATION DIVISION  
Wichita, Kansas

STATE OF KANSAS COUNTY OF SEDGWICK  
John H. Knightley Agent (employee of owner) of  
of the above-described well, being first duly sworn on oath, says: That I have knowledge of the facts, statements, and matters herein contained and the log of the above-described well as filed and that the same are true and correct. So help me God.

(Signature) John H. Knightley  
221 S. Broadway, Wichita, Kansas 67202  
(Address)

SUBSCRIBED AND SWORN TO before me this 11th day of August, 1980

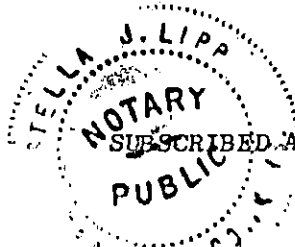

Stella J. Lipp  
Notary Public.

My commission expires March 12, 1983

15-155-20676-0000

Oil Properties Co., Inc. - Yoder #1  
Box 335 SW SW SE Sec. 22-24S-5W  
Andover, Kansas 67002 Reno County, Kansas

Contractor: D. R. Lauck Oil Company, Inc.  
221 S. Broadway, Suite 400  
Wichita, Kansas 67202

Commenced: July 11, 1980

Completed: July 13, 1980

Drillers Log

Clay, Sand, Red Bed	295
Red Bed & Shale	609
Lost circulation, and skid rig 12' east.	

RECEIVED  
STATE CORPORATION COMMISSION

AUG 13 1980

CONSERVATION DIVISION  
Wichita, Kansas

8-13-80