


STATE OF KANSAS
STATE CORPORATION COMMISSION

Give All Information Completely
Make Required Affidavit
Mail or Deliver Report to:
Conservation Division
State Corporation Commission
211 No. Broadway
Wichita, Kansas

WELL PLUGGING RECORD

NORTH

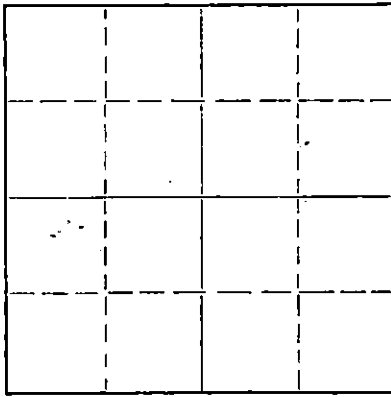

Locate well correctly on above
Section Plat

Reno County. Sec. 26 Twp. 24S Rge. 5W (E) (W)
Location as "NE/CNW/SW" or footage from lines C. NW NE SE
Lease Owner Hudson Oil Company
Lease Name Miller Well No. 1
Office Address 1112 Southwest Blvd. Kansas City 3, Kansas
Character of Well (completed as Oil, Gas or Dry Hole) Dry Hole
Date well completed January 11, 1959 19
Application for plugging filed January 11, 1959 19
Application for plugging approved January 11, 1959 19
Plugging commenced January 15, 1959 19
Plugging completed January 15, 1959 19
Reason for abandonment of well or producing formation Dry Hole

If a producing well is abandoned, date of last production 19
Was permission obtained from the Conservation Division or its agents before plugging was commenced? Yes

Name of Conservation Agent who supervised plugging of this well Fred Hampel, Pretty Prairie, Kansas
Producing formation Depth to top Bottom Total Depth of Well 3837 Feet
Show depth and thickness of all water, oil and gas formations.

OIL, GAS OR WATER RECORDS

CASING RECORD

FORMATION	CONTENT	FROM	TO	SIZE	PUT IN	PULLED OUT
				8 5/8"	255' w/165 sacks	

Describe in detail the manner in which the well was plugged, indicating where the mud fluid was placed and the method or methods used in introducing it into the hole. If cement or other plugs were used, state the character of same and depth placed, from feet to feet for each plug set.

Set plug at 240' with 20 sacks cement. Mud to 40'. Set plug at 40' with 10 sacks cement. Cemented to bottom of Cellar. Cemented rat hole with 2 sacks cement.

RECEIVED
STATE CORP. DIV.

JAN 23 1959

CONSERVATION DIVISION
Wichita, Kansas

1-23-59

(If additional description is necessary, use BACK of this sheet)

Name of Plugging Contractor Veeder Supply and Development Co.
Address Box 201, Cherryvale, Kansas

STATE OF Kansas, COUNTY OF Montgomery, ss.
C. H. Woods (employee of owner) or (owner or operator)

well, being first duly sworn on oath, says: That I have knowledge of the facts, statements, and matters herein contained and the log of the above-described well as filed and that the same are true and correct. So help me God.

(Signature) C. H. Woods

Cherryvale, Kansas

(Address)

SUBSCRIBED AND SWORN TO before me this 19th day of January, 1959


Cleo Lawson

Notary Public.

My commission expires July 11, 1960

PLUGGING
FILE SEC 26 T. 24 R. 5W
BOOK PAGE 13 LINE 21

Veeder Supply & Dev'l. Co.

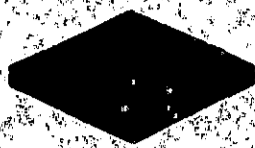

Cherryvale, Kansas

Drilled for Hudson Oil Company Farm Miller No. 1 Depth 3837'
 Contractor Veeder Supply & Development Co. Pipe 255' 8 5/8" csg. w/165 sacks
 Location C. NW/4 NE/4 SE/4 Sec. 26 Twp. 24S Range 5W
 Commenced 12-20-58 Completed 1-14-59 County Reno State Kansas

Cellar	0	9	9
Native Clay	9	50	41
Sand	50	70	20
Shale, shells	70	715	645
Shale	715	935	220
Shale w/lime streaks	935	1050	115
Lime w/shale streaks	1050	1120	70
Lime and shale	1120	12070	150
Lime and shale streaks	1270	1515	245
Shale w/lime streaks	1515	1706	191
Lime and shale	1706	1735	29
Shale and lime	1735	1980	245
Shale	1980	2100	120
Shale and lime	2100	2345	245
Lime and shale	2345	2571	226
Shale	2571	2650	79
Lime	2650	2915	265
Lime and shale	2915	2936	21
Lime	2936	2955	19
Lime and shale	2955	2998	43
Lime	2998	3120	122
Lime and shale	3120	3276	156
Shale and lime streaks	3276	3312	36
Lime and shale	3312	3375	63
Lime, shale, chert	3375	3397	22
Mississippi	3397	3580	183
Lime and shale	3580	3595	15
Shale and lime	3595	3634	39
Lime and shale	3634	3684	50
Shale and lime	3684	3745	61
Lime and shale	3745	3785	40
Shale and lime	3785	3832	47
Sand	3832	3837	5
T. D.	3837		

D&A

RECEIVED
 STATE CORPORATION COMMISSION
 JAN 23 1959
 CONSERVATION DIVISION
 1-23-59

AFFIDAVIT

STATE OF KANSAS)
 Montgomery County) SS

C. H. Woods, of lawful age, being first duly sworn on oath, deposes and says:

THAT he has read the above drilling log covering the Miller #1 well located in Section 26-24S-5W, Reno County, Kansas, and that the same is true and correct. Further Affiant saith not.

THE VEEDER SUPPLY AND DEVELOPMENT CO.
 By: C. H. Woods
 C. H. Woods

Subscribed and sworn to before me this 19th day of January, 1959.

John Lawson
 Notary Public

My commission expires July 11, 1960.

PLUGGING
 FILE SEC. 26 T. 24 R. 5W
 BOOK PAGE 13 LINE 21