


STATE OF KANSAS  
STATE CORPORATION COMMISSION

Give All Information Completely  
Make Required Affidavit  
Mail or Deliver Report to:  
Conservation Division  
State Corporation Commission  
211 No. Broadway  
Wichita, Kansas

WELL PLUGGING RECORD

NORTH

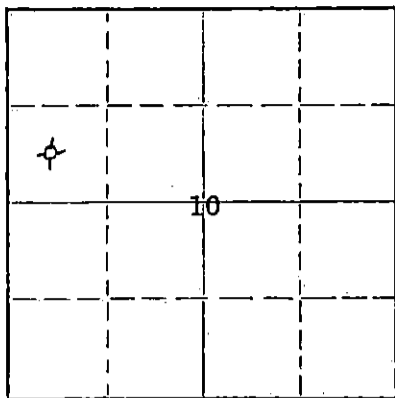

Locate well correctly on above  
Section Plat

Stafford County, Sec. 10 Twp. 25S Rge. 11 (E) W (W)  
Location as "NE/CNWxSWx" or footage from lines C SW NW  
Lease Owner W. G. McBride, Inc.  
Lease Name Delbert McCune Well No. 1  
Office Address 805 Mayo Building, Tulsa 3, Oklahoma  
Character of Well (completed as Oil, Gas or Dry Hole) Dry hole  
Date well completed December 15, 1960  
Application for plugging filed (Verbally) December 15, 1960  
Application for plugging approved (Verbally) December 15, 1960  
Plugging commenced December 16, 1960  
Plugging completed December 16, 1960  
Reason for abandonment of well or producing formation Dry Hole

If a producing well is abandoned, date of last production \_\_\_\_\_ 19\_\_\_\_  
Was permission obtained from the Conservation Division or its agents before plugging was commenced? Yes

Name of Conservation Agent who supervised plugging of this well Mr. John Broadfoot, 222 S. Main, St. John, Kansas  
Producing formation Dry Hole Depth to top \_\_\_\_\_ Bottom \_\_\_\_\_ Total Depth of Well \_\_\_\_\_ Feet  
Show depth and thickness of all water, oil and gas formations.

OIL, GAS OR WATER RECORDS

CASING RECORD

FORMATION	CONTENT	FROM	TO	SIZE	PUT IN	PULLED OUT
				8-5/8"	263	None

Describe in detail the manner in which the well was plugged, indicating where the mud fluid was placed and the method or methods used in introducing it into the hole. If cement or other plugs were used, state the character of same and depth placed, from \_\_\_\_\_ feet to \_\_\_\_\_ feet for each plug set.

Circulated heavy mud to total depth 4130 feet. pumped 20-sack cement plug from 255 feet to 193 feet. Pumped mud from 193 feet to 35 feet. Pumped 10-sack cement plug from 35 feet to base of cellar.

RECEIVED  
STATE CORPORATION COMMISSION  
DEC 23 1960  
CONSERVATION DIVISION  
Wichita, Kansas

12-23-60

(If additional description is necessary, use BACK of this sheet)

Name of Plugging Contractor Garvey Drilling Company  
Address Rural Route 2, Great Bend, Kansas

STATE OF OKLAHOMA, COUNTY OF TULSA, ss.  
Clark S. Minnich (employee of owner) or (owner or operator) of the above-described well, being first duly sworn on oath, says: That I have knowledge of the facts, statements, and matters herein contained and the log of the above-described well as filed and that the same are true and correct. So help me God.

(Signature) Clark S. Minnich  
805 Mayo Building, Tulsa 3, Oklahoma  
(Address)

SUBSCRIBED AND SWORN to before me this 22nd day of December, 1960

My commission expires 2-5-64

Valeria C. Boyd  
Notary Public.



# WELL LOG

COMPANY **W. C. MC BRIDE, INC.**

SEC. 10 T. 25S R. 11W

FARM **MC CUNE** NO. 1


LOC. **C-SW, NW**

TOTAL DEPTH **4130'**

COUNTY **STAFFORD CO., KANSAS**

COMM. **December 3, 1960** COMP. **December 16, 1960**

CONTRACTOR **GARVEY DRILLING COMPANY**

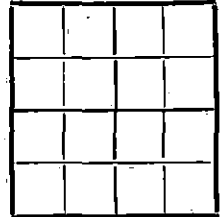

CASING **8 5/8" @ 263' w/225 sax.**

ELEVATION **1799' DF**

PRODUCTION **D & A**

FIGURES INDICATE BOTTOM OF FORMATIONS

263	Sand & shale
450	Shale & shells
540	Shale
590	Anhydrite
1176	Shale & anhydrite streaks
1560	Shale & shells
1780	Lime & shale
2500	Lime
2710	Lime & shale
3035	Shale & lime
3150	Lime & shale
3240	Lime
3325	Lime & shale
3415	Shale
3923	Lime
4015	Vicla
4045	Lime & shale
4085	Lime
4130	Arbuskie
4130	T. D.

CHECK NUMBER  
**87042**  
ISSUED

**RECEIVED**  
STATE CORPORATION COMMISSION  
MAY 17 1965  
CONSERVATION DIVISION  
Wichita, Kansas

State of KANSAS }  
County of BARTON } ss.

I, VERNE A. MORRIS of GARVEY DRILLING COMPANY

upon oath state that the above and foregoing is a true and correct copy of the log of the #1 MC CUNE well

*Verne A. Morris*

Subscribed and sworn to before me this 23rd day of December 1960

My Commission Expires: April 14, 1963

*Arthur J. Morris*  
NOTARY PUBLIC