


Give All Information Completely
Make Required Affidavit
Mail or Deliver Report to:
Conservation Division
State Corporation Commission
212 No. Market
Wichita, Kansas

WELL PLUGGING RECORD

NORTH

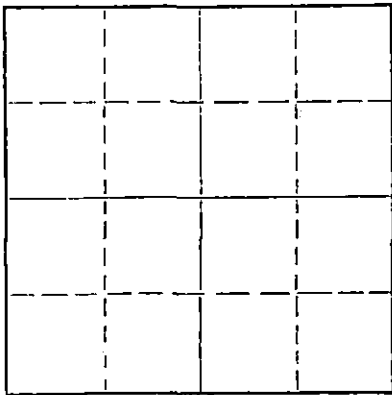

Locate well correctly on above
Section Plat

Pratt County, Sec. 1 Twp. 26s Rge. 15 (W)
Location as "NE/CNW/SW" or footage from lines SW NE SE
Lease Owner Santa-Fe Pipe & Supply, Inc.,
Lease Name Thompson Well No. 1
Office Address Box 562, Great Bend, Kansas
Character of Well (completed as Oil, Gas or Dry Hole) gas
Date well completed April 29 1962
Application for plugging filed June 15 1968
Application for plugging approved June 17 1968
Plugging commenced June 17 1968
Plugging completed June 20 1968
Reason for abandonment of well or producing formation depleted

If a producing well is abandoned, date of last production 19
Was permission obtained from the Conservation Division or its agents before plugging was commenced? yes

Name of Conservation Agent who supervised plugging of this well R. J. Warren
Producing formation Depth to top Bottom Total Depth of Well 4571' Feet
Show depth and thickness of all water, oil and gas formations.

OIL, GAS OR WATER RECORDS

CASING RECORD

FORMATION	CONTENT	FROM	TO	SIZE	PUT IN	PULLED OUT
				8-5/8"	288'	none
				4-1/2"	4035'	3007.27'

Describe in detail the manner in which the well was plugged, indicating where the mud fluid was placed and the method or methods used in introducing it into the hole. If cement or other plugs were used, state the character of same and depth placed, from feet to feet for each plug set.

4571' - 3850' - plug
3850' - 3775' - sand
3775' - 3739' - 3 sacks cement
3739' - 280' - mud
280' - 270' - rock bridge and calseal
270' - 195' - 25 sacks cement
195' - 40' - mud
40' - 30' - rock bridge
30' - base - 10 sacks cement

RECEIVED
STATE CORPORATION COMMISSION
JUL 15 1968
CONSERVATION DIVISION
Wichita, Kansas

(If additional description is necessary, use BACK of this sheet)

Name of Plugging Contractor Santa-Fe Pipe & Supply, Inc.,
Address Box 562, Great Bend, Kansas

STATE OF Kansas, COUNTY OF Barton, ss.
T. L. Nutt (owner or operator) of the above-described well, being first duly sworn on oath, says: That I have knowledge of the facts, statements, and matters herein contained and the log of the above-described well as filed and that the same are true and correct. So help me God.

(Signature) T. L. Nutt
Box 562, Great Bend, Kansas (Address)

SUBSCRIBED AND SWORN TO before me this 13th day of July, 19 68

My commission expires July 31, 1970

Mary M. Guessier
Notary Public.

D R I L L E R S L O G

#1 Thompson

CASING RECORD:
288' of new 8-5/8"
surface casing

CONTRACTOR: Strata Drilling, Inc. DESCRIPTION: SW NE SE
Section 1-26S-15W
COMPANY: Schermerhorn Oil Corp. ELEVATION: Pratt Co., Kans.
& Strata Drilling, Inc. 2027' RB

TOTAL DEPTH:
4571'

COMMENCED: April 16, 1962

COMPLETED: April 29, 1962

<u>FORMATION</u>	<u>FROM</u>	<u>TO</u>	<u>REMARKS</u>
Sand & Shale	0	289	Ran 288' of new 8-5/8" surface casing; set and cemented at 288' with 200 sacks of regular cement, 4% gel and 2% C. C. & 100 sacks of regular cement, 2% gel and 2% C. C. Plug down at 12:15 A. M. April 17, 1962.
Red Bed Shale	289	1380	
Shale & Shells	1380	1830	
Shale & Lime	1830	3860	
Lime	3860	4074	
Lime & Shale	4074	4130	
Lime	4130	4175	
Lime & Chert	4175	4224	
Cherty Lime	4224	4269	
Lime	4269	4328	
Chert & Lime	4328	4404	
Lime & Shale	4404	4430	
Lime	4430	4571	

Total Depth 4571'

RECEIVED
STATE CORPORATION COMMISSION
JUN 17 1968
CONSERVATION DIVISION
Wichita, Kansas

Ran Schlumberger Log.

Ran 4035' of 4 1/2" casing; set and cemented at 4035' with 125 sacks of 50-50 posmix, 2% gel with 18 lbs. of salt per sack. Plug down at 6:00 A. M. April 29, 1962.

4 1/2 x 7/8 5' per box 625'
4035' - 425' - 3385' - 23200

STATE OF KANSAS)
) ss.
COUNTY OF BARTON)

I certify that this is a true and correct copy of the above log to the best of my knowledge.

STRATA DRILLING, INC.

Jim B. McWilliams
Jim B. McWilliams, Secy-Treas.

Subscribed and sworn to before me this 30th day April, 1962.

Elaine H. Taylor
Elaine H. Taylor, Notary Public

My Commission Expires:
December 14, 1965