


15-151-20712-00-00

STATE OF KANSAS
STATE CORPORATION COMMISSION

WELL PLUGGING RECORD

Give All Information Completely
Make Required Affidavit
Mail or Deliver Report to
Conservation Division
State Corporation Comm.
245 North Water
Wichita, KS 67202

Pratt County, Sec. 16 Twp 26S Rge. 11 ~~xx~~/W
Location as "NE/CNW $\frac{1}{4}$ /SW $\frac{1}{4}$ " or footage from lines
SE SE NW
Lease Owner J.A. Allison
Lease Name Shriver Well No. 1
Office Address 300 W. Douglas, Suite 305, Wichita, Ks.
Character of Well (Completed as Oil, Gas or Dry Hole) 67202
dry hole

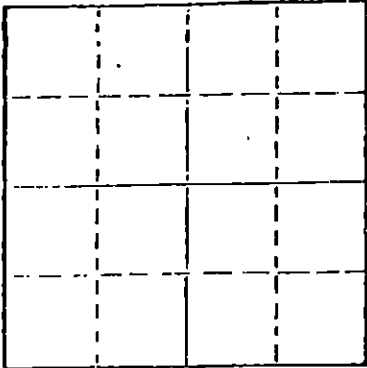

Locate well correctly on above
Section Plat

Date Well completed 4-12-1980
Application for plugging filed 4-12-1980
Application for plugging approved 4-12-1980
Plugging commenced 4-12-1980
Plugging completed 4-12-1980
Reason for abandonment of well or producing formation
no commercial quantity of oil or gas encountered
If a producing well is abandoned, date of last production
-- 19

Was permission obtained from the Conservation Division or
its agents before plugging was commenced? yes

Name of Conservation Agent who supervised plugging of this well Bill Owen
Producing formation Depth to top Bottom Total Depth of Well 4395
Show depth and thickness of all water, oil and gas formations.

OIL, GAS OR WATER RECORDS

CASING RECORD

FORMATION	CONTENT	FROM	TO	SIZE	PUT IN	PULLED OUT
surface hole	shale	surf	272	8-5/8"	264'	none

Describe in detail the manner in which the well was plugged, indicating where the mud fluid
was placed and the method or methods used in introducing it into the hold. If cement or other
plugs were used, state the character of same and depth placed, from feet to
feet for each plug set.

Fluid to 540', plug, 35 sx
Fluid to 270', plug, 50 sx
Fluid to 40', plug, 20 sx
Rate Hole 5 sx

4-22-80

STATE RECEIVED
STATE CORPORATION COMMISSION
APR 22 1980
CONSERVATION DIVISION
Wichita, Kansas

(If additional description for logs necessary, use BACK of this sheet)
Name of Plugging Contractor DRY DRILLING, INC.
515 R. H. Garvey Building
Wichita, Kansas 67202

STATE OF Kansas COUNTY OF Sedgwick
Ella Priess (employee of owner) or (owner or operator)
of the above-described well, being first duly sworn on oath, says: That I have knowledge of
the facts, statements, and matters herein contained and the log of the above-described well
as filed and that the same are true and correct. So help me God.

(Signature) Ella Priess
Suite 515 R.H. Garvey Bldg., Wichita, Ks.
(Address) 67202

SUBSCRIBED AND SWORN TO before me this 17th day of April, 19 80

Dorothy L. Schmidt
Dorothy L. Schmidt Notary Public.

My commission expires April 30, 1983

DOROTHY L. SCHMIDT
STATE NOTARY PUBLIC
Sedgwick County, Kansas
My Appt. Exp. April 30, 1983

DRILLER'S LOG

J. A. ALLISON
No. 1 Shriver
SE SE NW Sec 16-26S-11W
Pratt Co., Ks.

Commenced: 3-27-80
Completed: 4-12-80

Surface Casing: 264' of 8-5/8"
cemented w/280 sx common, 2% gel,
3% cc

FORMATION

DEPTH

Surface Hole	0 - 272
Shale & Red Bed	272 - 1415
Shale	1415 - 2012
Shale & Lime	2012 - 2910
Lime & Shale	2910 - 3672
Lime	3672 - 4395 RTD

I do hereby certify that the foregoing statements are true and correct to the best of my knowledge and belief.

D N B DRILLING, INC.

Ella Priess

Ella Priess

STATE OF KANSAS: ss:

Subscribed and sworn to before me this 17th day of April, 1980.

Dorothy L. Schmidt
Dorothy L. Schmidt, Notary Public

DOROTHY L. SCHMIDT
STATE NOTARY PUBLIC
Sedgwick County, Kansas
My Appt. Exp. April 30, 1983

RECEIVED
REGISTRATION COMMISSION
APR 22 1980
CONSERVATION DIVISION
Wichita, Kansas