


Give All Information Completely  
Make Required Affidavit  
Mail or Deliver Report to:  
Conservation Division  
State Corporation Commission  
211 No. Broadway  
Wichita, Kansas

WELL PLUGGING RECORD

Pratt County. Sec. 7 Twp. 29S Rge. 14W (W)

Location as "NE/CNW/SW" or footage from lines C NE SW  
Lease Owner D.R. Lauck Oil Company, Inc. & Philip F. Anschutz  
Lease Name Stelzer Well No. 1  
Office Address 301 S. Broadway, Wichita, Kansas  
Character of Well (completed as Oil, Gas or Dry Hole) Dry Hole  
Date well completed September 17, 1963  
Application for plugging filed September 17, 1963  
Application for plugging approved September 17, 1963  
Plugging commenced September 17, 1963  
Plugging completed September 17, 1963  
Reason for abandonment of well or producing formation Dry Hole

NORTH

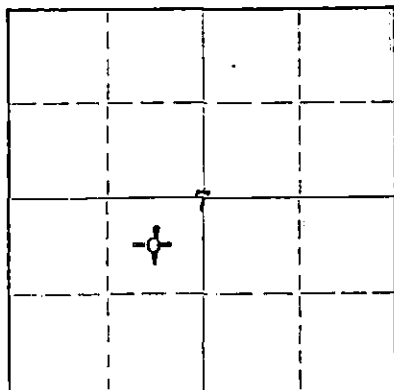

Locate well correctly on above  
Section Plat

If a producing well is abandoned, date of last production \_\_\_\_\_ 19\_\_\_\_  
Was permission obtained from the Conservation Division or its agents before plugging was commenced? Yes

Name of Conservation Agent who supervised plugging of this well Archie Elving  
Producing formation \_\_\_\_\_ Depth to top \_\_\_\_\_ Bottom \_\_\_\_\_ Total Depth of Well 4910 Feet  
Show depth and thickness of all water, oil and gas formations.

OIL, GAS OR WATER RECORDS

CASING RECORD

FORMATION	CONTENT	FROM	TO	SIZE	PUT IN	PULLED OUT
		0'	311'	8-5/8"	311'	None

Describe in detail the manner in which the well was plugged, indicating where the mud fluid was placed and the method or methods used in introducing it into the hole. If cement or other plugs were used, state the character of same and depth placed, from \_\_\_\_\_ feet to \_\_\_\_\_ feet for each plug set.

4910'-275' Mud  
275'-271' Plug  
271'-231' Cement, 20 sacks; 1/2 sack hulls.  
231'-40' Mud  
40'-36' Plug  
36'-6' Cement, 10 sacks; 1/4 sack hulls.  
(Bottom of cellar)

RECEIVED  
STATE CORPORATION COMMISSION

SEP 23 1963

CONSERVATION DIVISION  
Wichita, Kansas

(If additional description is necessary, use BACK of this sheet)

Name of Plugging Contractor Sun Cementing Co.  
Address Great Bend, Kansas

STATE OF KANSAS, COUNTY OF SEDGWICK, ss.  
John H. Knightley (employee of owner) or (owner or operator) of the above-described

well, being first duly sworn on oath, says: That I have knowledge of the facts, statements, and matters herein contained and the log of the above-described well as filed and that the same are true and correct. So help me God.

(Signature) John H. Knightley  
301 S. Broadway, Wichita, Kansas  
(Address)

SUBSCRIBED AND SWORN TO before me this 20th day of September, 1963

My commission expires March 12, 1967

Stella J. Lippis  
Notary Public.

D. R. LAUCK OIL COMPANY, INC.  
and  
PHILIP F. ANSCHUTZ

Stelzer #1

C NE SW Sec. 7-29S-14W  
Pratt County, Kansas

Commenced: August 31, 1963  
Completed: September 17, 1963

Casing Record: 311' 8-5/8" Cemented with 250 sacks Cement,  
5 sacks Calcium Chloride.

Elevation: GL 2027; DF 2029; KB 2031.

Drillers Log

Tops

Clay	95		
Sand	200		Elec. Log
Red Bed	350	Heebner	3899-1868
Red Bed & Sand	895	Douglas Shale	4020-1989
Anhydrite	915	Brown Lime	4070-2039
Red Bed	1250	Lansing	4083-2052
Shale & Shells	1825	Base Kansas City	4462-2431
Anhydrite & Shale	2175	Marmaton Lime	4484-2453
Lime	2350	Marmaton Chert	4541-2510
Lime & Shale	2720	Mississippian Chert	4636-2605
Shale & Lime	2810	Kinderhook	4657-2626
Brown Lime & Shale	2930	Viola	4683-2652
Shale & Lime	3330	Simpson Shale	4802-2771
Lime	3495	Arbuckle	4899-2868
Lime & Shale	3705	Total Depth	4910-2879
Lime	3775		
Lime & Shale, some chalky	3895		
Shale & Lime	3965		
Chalky Lime	4020		
Shale & Lime	4110		
Lime	4291		
Lime, cherty	4310		
Lime	4620		
Lime, Chert & Shale	4700		
Lime	4735		
Lime, Shale & Chert	4770		
Chert & Shale	4800		
Lime & Chert	4850		
Shale, Chert & Lime	4900		
Lime	4910 RTD		

RECEIVED  
STATE CORPORATION COMMISSION

SEP 23 1963

D&A

CONSERVATION DIVISION  
Wichita, Kansas

I hereby certify that this is a true and correct log of the above mentioned well, to the best of my knowledge and belief.

Subscribed and sworn to before me this 20th day of September, 1963.

My commission expires March 12, 1967.

*Stella J. Lippa*  
Notary Public