

STATE OF KANSAS
STATE CORPORATION COMMISSION

WELL PLUGGING RECORD

Give All Information Completely
Make Required Affidavit
Mail or Deliver Report to:
Conservation Division
State Corporation Commission
211 No. Broadway
Wichita, Kansas

Pratt County. Sec. 5 Twp. 29 Rge. 14 (R) W (W)

Location as "NE/CNW%SW%" or footage from lines NE NE SW

Lease Owner Aurora Gasoline Company etal

Lease Name Jenkins Well No. 1

Office Address 1107 Union Nat'l Bank Bldg., Wichita, Kansas

Character of Well (completed as Oil, Gas or Dry Hole) Dry hole

Date well completed May 15 19 57

Application for plugging filed May 16 19 57

Application for plugging approved May 16 19 57


Plugging commenced May 16 19 57

Plugging completed May 16 19 57

Reason for abandonment of well or producing formation Dry hole

If a producing well is abandoned, date of last production None 19

Was permission obtained from the Conservation Division or its agents before plugging was commenced? yes

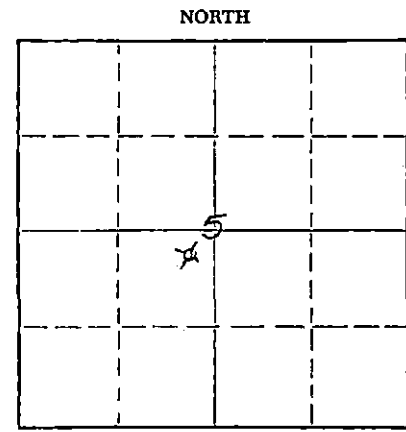

Locate well correctly on above Section Plat

Name of Conservation Agent who supervised plugging of this well M. A. Rives

Producing formation None Depth to top Bottom Total Depth of Well 4770 Feet

Show depth and thickness of all water, oil and gas formations.

OIL, GAS OR WATER RECORDS

CASING RECORD

FORMATION	CONTENT	FROM	TO	SIZE	PUT IN	PULLED OUT

Describe in detail the manner in which the well was plugged, indicating where the mud fluid was placed and the method or methods used in introducing it into the hole. If cement or other plugs were used, state the character of same and depth placed, from feet to feet for each plug set.

Hole filled with heavy Drilling Mud
to 275'. 1/2 sack hulls placed at 275'
20 sacks of cement run on top of hulls.
Hole filled with mud to 35'. 1/2 sack
hulls placed at 35'. Hole filled from 35'
to surface with 10 sacks cement.

(If additional description is necessary, use BACK of this sheet)

Name of Plugging Contractor Graybol Oil Corporation

Address 425 National Bank of Tulsa Building, Tulsa, Oklahoma

STATE OF Oklahoma COUNTY OF Tulsa, ss.
A. N. Ward (employee of owner) or (owner or operator) of the above-described well, being first duly sworn on oath, says: That I have knowledge of the facts, statements, and matters herein contained and the log of the above-described well as filed and that the same are true and correct. So help me God.

(Signature) [Signature]

(Address)

SUBSCRIBED AND SWORN TO before me this 20 day of May, 19 57

My commission expires

May 10, 1961

F. M. Reukat

RECEIVED
STATE CORPORATION COMMISSION
Notary Public.

MAY 23 1957

CONSERVATION DIVISION
Wichita, Kansas

PLUGGING
FILE SEC. 5 T. 29 R. 14W
BOOK PAGE 14 LINE 23

AURORA GASOLINE COMPANY

PRATT COUNTY, KANSAS

JENKINS No. 1

NE NE SW

Sec. 5, Twp. 29-S, Rge. 14-W

Contractor: Graybol Oil Corporation (Rig No. 3)

Elev: 2024' G.L., 2029' D.F., 2032'R.B.

Drilling Commenced: 4-25-57

Drilling Completed: 5-15-57

Production: Dry hole.

CASING RECORD

276' of 8 5/8" surface casing cemented with 200 sacks.

DEPTH	STRATA	FORMATION TOPS:	
0 - 300	Surface	Douglas Shale	3896'
300 - 1410	Red bed and shale	Brown Lime	4019'
1410 - 1750	Shale and sand	Lansing Lime	4032'
1750 - 2136	Shale and lime	Mississippian	4502'
2136 - 2700	Lime	Viola	4533'
2700 - 2940	Lime and shale	Simpson Shale	4657'
2940 - 3530	Shale and lime	Arbuckle	4733'
3530 - 3617	Lime and shale		
3617 - 3698	Sand and lime		
3698 - 4127	Lime		
4127 - 4175	Lime and sand		
4175 - 4666	Lime		
4666 - 4710	Sand		
4710 - 4770	Lime		
Total Depth	4770'		

Drill-stem Tests:

No. 1, 4199-4236, open 1 hour, Recovered 40' slightly oil-cut mud. B.H. Pressure 705# shut in for 20 minutes.

No. 2, 4244-4294, open 1 hour. Recovered 240' salt water. B.H. Pressure 1490# shut in for 20 minutes.

No. 3, 4500-4559, open 1/2 hour, Recovered 20' mud. B.H. Pressure 0#, shut in for 20 minutes.

No. 4, 4562-4621, open 1 hour, Recovered 2250' gas & 75' slightly oil and gas-cut mud. B.H. Pressure 30# shut in for 20 minutes.

I hereby certify that the above is a true and correct log of said well as reflected by the daily drilling reports.

GRAYBOL OIL CORPORATION

By: Jack Cole
Jack Cole, Geologist

STATE OF OKLAHOMA, COUNTY OF TULSA, ss

Subscribed and sworn to before me this 20 day of May, 1957.

June J. Block
Notary Public

My Commission expires March 8, 1961.

PLUGGING			
FILE	SEC	T	14W
	5	29	
BOOK	PAGE	LINE	3
	14		