


STATE OF KANSAS
CORPORATION COMMISSION
All Information Completely
Make Required Affidavit
Mail or Deliver Report to:
Conservation Division
State Corporation Commission
211 No. Broadway
Wichita, Kansas

WELL PLUGGING RECORD

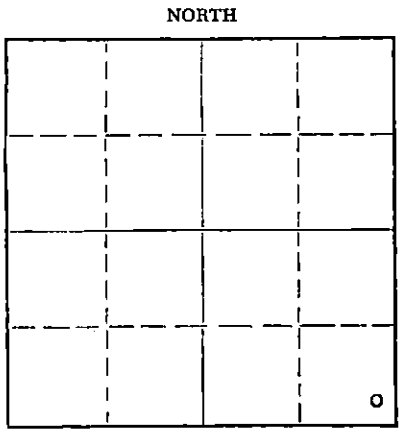

Locate well correctly on above
Section Plat

Pratt County. Sec. 4 Twp. 29S Rge. 14 (E) (W)
Location as "NE/CNW/SW" or footage from lines SE/4 SE/4 SE/4
Lease Owner Twin Drilling, Inc.
Lease Name Moore Well No. 1
Office Address 1005 Central Building, Wichita, Kansas
Character of Well (completed as Oil, Gas or Dry Hole) Dry
Date well completed 7-25 1958
Application for plugging filed 7-29 1958
Application for plugging approved 7-30 1958
Plugging commenced 7-26 1958
Plugging completed 7-26 1958
Reason for abandonment of well or producing formation Dry Hole

If a producing well is abandoned, date of last production None 19
Was permission obtained from the Conservation Division or its agents before plugging was commenced? Yes

Name of Conservation Agent who supervised plugging of this well Mr. W. L. Lackamp
Producing formation Depth to top Bottom Total Depth of Well 4708 Feet
Show depth and thickness of all water, oil and gas formations.

OIL, GAS OR WATER RECORDS

CASING RECORD

FORMATION	CONTENT	FROM	TO	SIZE	PUT IN	PULLED OUT
				8 5/8"	260.39	-

Describe in detail the manner in which the well was plugged, indicating where the mud fluid was placed and the method or methods used in introducing it into the hole. If cement or other plugs were used, state the character of same and depth placed, from feet to feet for each plug set.

Set plug at 240' and cement through drill pipe
with 20 sacks cement. Fill up to 35' of base of
cellar. Set plug and cap with 10 sacks mixed cement

(If additional description is necessary, use BACK of this sheet)
Name of Plugging Contractor Twin Drilling, Inc.
Address 1005 Central Building, Wichita, Kansas

STATE OF Kansas, COUNTY OF Sedgwick, ss.
Almeda Day (employee of owner) or (owner or operator) of the above-described well, being first duly sworn on oath, says: That I have knowledge of the facts, statements, and matters herein contained and the log of the above-described well as filed and that the same are true and correct. So help me God.

(Signature) Almeda Day
(Address)

SUBSCRIBED AND SWORN TO before me this 6 day of August 19 58
My commission expires September 29, 1960
James L. Lackamp Notary Public.

PLUGGING
FILE SEC 4 T. 29 R. 14
BOOK PAGE 119 LINE 6

AUG 7 1958
CONSERVATION DIVISION
Wichita, Kansas

WELL LOG

Well: Moore #1
Location: SE/4 SE/4 SE/4
Section 4-29S-14W
Pratt County, Kansas
Elevation: 2013 GR.
Casing: 260.39' 8 5/8" Surface
Cemented W/175 Sax

Contractor: Twin Drilling, Inc.
1005 Central Building
Wichita, Kansas
Operator: Same
Commenced: 7-10-58
Completed: 7-25-58

Tops

Surface 143
Shale 235
Shells & Shale 253
Red Bed 320
Shale & Shells 1335
Shale & Lime Shells 1840
Shale & Lime 1970
Lime 2255
Lime W/Shale Breaks 2406
Lime 2560
Shale & Lime 3430
Lime 3595
Lime & Shale 3634
Lime 4011
Kansas City Lime 4040
Lime 4388
Lime & Shale 4432
Lime 4475
Lime & Shale 4506
Lime 4534
Lime & Chert 4610
Lime, Sand & Shale 4682
Lime & Shale 4683
Arbuckle Lime 4708

Heebner 3816
Douglas 3864
Douglas Sandstone 3934
Brown Lime 3994
Lansing 4008
Base Kansas City 4378
Marmaton Chert 4439
Mississippi 4463
Kinderhook 4474
Kinderhook Sandstone 4486
Viola 4503
Simpson Dolomite 4583
Simpson Shale 4591
Simpson Sandstone 4609
Arbuckle 4678

T.D. 4708' D. & A.

STATE OF KANSAS)
) ss.
COUNTY OF SEDGWICK)

The undersigned, TWIN DRILLING, INC., hereby certifies that the above log is a true and correct log of the formations encountered in drilling the above well as reflected by the Daily Drilling Report.

TWIN DRILLING, INC.

By: Almeda Day

Subscribed and sworn to before me this 6th day of August, 1958.

James A. Nichols
Notary Public

My commission expires September 29, 1960.

RECEIVED
CORPORATION COMMISSION

AUG 7 1958

PLUGGING
FILE SEC: 4 T. 29 R. 14W
BOOK PAGE 119 LINE 6

CONSERVATION DIVISION
Wichita, Kansas