


STATE OF KANSAS  
STATE CORPORATION COMMISSION

WELL PLUGGING RECORD

Give All Information Completely  
Make Required Affidavit  
Mail or Deliver Report to:  
Conservation Division  
State Corporation Commission  
800 Bitting Building  
Wichita, Kansas

Pratt County, Sec. 2 Twp. 29 Rge. 14 (E) 14 (W)

Location as "NE/CNW $\frac{1}{4}$ /SW $\frac{1}{4}$ " or footage from lines Ctr. NW/4 NW/4 NW/4  
Lease Owner Lion Oil Company  
Lease Name Omo Well No. 1  
Office Address P. O. Box 639, Pratt, Kansas  
Character of Well (completed as Oil, Gas or Dry Hole) Dry Hole  
Date well completed 2-19 19 52  
Application for plugging filed 2-18 19 52  
Application for plugging approved 2-19 19 52  
Plugging commenced 2-19 19 52  
Plugging completed 2-19 19 52  
Reason for abandonment of well or producing formation Dry Hole

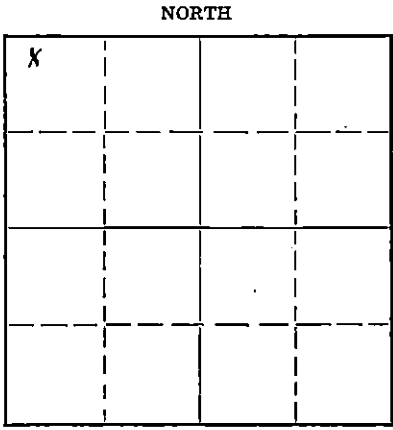

Locate well correctly on above Section Plat

If a producing well is abandoned, date of last production 19  
Was permission obtained from the Conservation Division or its agents before plugging was commenced? Yes

Name of Conservation Agent who supervised plugging of this well C. D. Stough  
Producing formation Depth to top Bottom Total Depth of Well 4694' Feet  
Show depth and thickness of all water, oil and gas formations.

OIL, GAS OR WATER RECORDS

CASING RECORD

Formation	Content	From	To	Size	Put In	Pulled Out

Describe in detail the manner in which the well was plugged, indicating where the mud fluid was placed and the method or methods used in introducing it into the hole. If cement or other plugs were used, state the character of same and depth placed, from feet to feet for each plug set.

Mud to 300'. Set Plug @ 300' with 15 sacks cement.  
Heavy mud to 35'. Set Plug @ 35' with 10 sacks to surface. Plugging completed.

(If additional description is necessary, use BACK of this sheet)  
Name of Plugging Contractor R. W. Rine Drilling Company  
Address 320 Central Bldg., Wichita, Kansas

STATE OF Kansas, COUNTY OF Pratt, ss.  
Vernon Hayes (employee of owner)

being first duly sworn on oath, says: That I have knowledge of the facts, statements, and matters herein contained and the log of the above-described well as filed and that the same are true and correct. So help me God.

(Signature) *Vernon Hayes*

P. O. Box 639, Pratt, Kansas (Address)

SUBSCRIBED AND SWORN to before me this 26<sup>TH</sup> day of February, 1952

*Van Saubek*  
Notary Public.

My commission expires August 29, 1955

PLUGGING  
FILE SEC 2 T 29 R 14 W  
BOOK PAGE 145 LINE 32

6-51-20M FEB 27 1952 02-27-52

Oil Well No. 1

NW NW NW  
Sec. 2-29S-14W  
PRATT COUNTY, KANSAS

CONTRACTOR: THE R. W. RINE DRILLING COMPANY  
STARTED: JAN. 31, 1952

FINISHED: FEB. 19, 1952

LOG

SAND AND CLAY	0 - 395	8-5/8" @ 390'	w/225 Sx.
SHALE AND SHELLS	395 - 450		
RED CLAY, SHALE, & SHELLS	450 - 1025	Syfo @ 500'	- OK
SHALE AND SHELLS	1025 - 1515	Syfo @ 1000'	- 10
SHALE AND LIME SHELLS	1515 - 1760	Syfo @ 1500'	- OK
LIME AND SHELLS	1760 - 2065	Syfo @ 2000'	- 10
LIME AND SHALE	2065 - 2185		
LIME	2185 - 2605	Syfo @ 2500'	- 10
LIME AND SANDY SHALE	2605 - 2730		
SHALE AND LIME	2730 - 3215	Syfo @ 3000'	- 10
LIME	3215 - 3798	Syfo @ 3500'	- 10
LIME AND SAND	3798 - 3875		
SAND AND SHALE	3875 - 3975		
LIME	3975 - 4003	Syfo @ 4000'	- OK
SHALE AND LIME	4003 - 4075		
LIME	4075 - 4443	Syfo @ 4350'	- 10
LIME AND SAND	4443 - 4491		
CHERT AND LIME	4491 - 4575	Syfo @ 4500'	- OK
LIME	4575 - 4600		
SAND	4600 - 4607		
SHALE AND SAND	4607 - 4642		
LIME	4642 - 4694	R.T.D.	BOTTOM PLUG @ 300' w/15 Sx. TOP PLUG @ 35' w/10 Sx. HEAVY MUD BETWEEN PLUGS.

STATE OF KANSAS }  
COUNTY OF SEDGWICK } ss.

I, R. M. GREEN, DO HEREBY CERTIFY THAT THE ABOVE IS A TRUE AND ACCURATE LOG OF THE OIL WELL NO. 1, LOCATED NW NW NW, SECTION 2-29S-14W, PRATT COUNTY, KANSAS.

*R. M. Green*  
ASSISTANT SECRETARY

SUBSCRIBED TO AND SWORN BEFORE ME THIS 23RD DAY OF FEBRUARY, 1952.

*Louisa J. Pederson*  
NOTARY PUBLIC

MY COMMISSION EXPIRES APRIL 20, 1955.

PLUGGING  
FILE SEC-2-T-29-R-140  
PAGE 145 LINE 38