


STATE OF KANSAS
 STATE CORPORATION COMMISSION
 Give All Information Completely
 Make Required Affidavit
 Mail or Deliver Report to:
 Conservation Division
 State Corporation Commission
 212 North Market, Insurance Bldg.
 Wichita, Kansas

15-151-10038-00.00
WELL PLUGGING RECORD

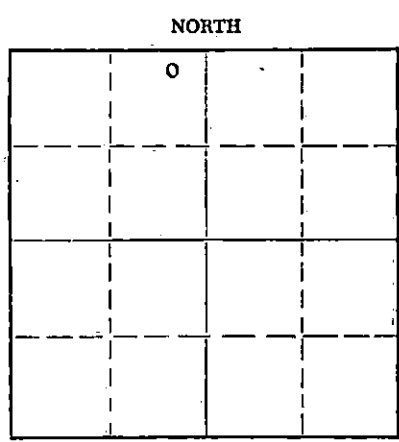

Pratt County, Sec. 1 Twp. 29 Rge. (E) 14 (W)
 Location as "NE/CNW/SW" or footage from lines NE NE NW
 Lease Owner Lario Oil & Gas Co.
 Lease Name Earl Moore Well No. 2
 Office Address 301 S. Market, Wichita, Kansas
 Character of Well (completed as Oil, Gas or Dry Hole) Oil
 Date well completed October 13, 1954
 Application for plugging filed July 12, 1960
 Application for plugging approved July 13, 1960
 Plugging commenced August 8, 1960
 Plugging completed August 15, 1960
 Reason for abandonment of well or producing formation Depleted

If a producing well is abandoned, date of last production June 3, 1960
 Was permission obtained from the Conservation Division or its agents before plugging was commenced? Yes

Name of Conservation Agent who supervised plugging of this well Frank Broadfout
 Producing formation Simpson Depth to top 4530 Bottom 4543 Total Depth of Well 4653 Feet
 Show depth and thickness of all water, oil and gas formations.

OIL, GAS OR WATER RECORDS					CASING RECORD		
FORMATION	CONTENT	FROM	TO	SIZE	PUT IN	PULLED OUT	
				8 5/8"	371'6"	None	
				5 1/2"	4653'	3833'	

Describe in detail the manner in which the well was plugged, indicating where the mud fluid was placed and the method or methods used in introducing it into the hole. If cement or other plugs were used, state the character of same and depth placed, from _____ feet to _____ feet for each plug set.

Set plug at 4300', sand to 4270'. 4 sacks cement to 4245'. Mud from 4245' to 300', rock 300' to 290'. 20 sacks cement from 290' to 230'. Mud from 230' to 35'. Rock bridge from 35' to base of cellar and 10 sacks cement.

RECEIVED
 STATE CORPORATION COMMISSION
 SEP 8 1960
 CONSERVATION DIVISION
 Wichita, Kansas

(If additional description is necessary, use BACK of this sheet)
 Name of Plugging Contractor Glenn & Smith Pipe Pulling Co.
 Address Ellinwood, Kansas

STATE OF KANSAS, COUNTY OF SEDGWICK, ss.
Leo Ross (employee of owner) or (~~owner~~) of the above-described well, being first duly sworn on oath, says: That I have knowledge of the facts, statements, and matters herein contained and the log of the above-described well as filed and that the same are true and correct. So help me God.

(Signature) [Signature]
301 S. Market, Wichita 2, Kansas
 (Address)

SUBSCRIBED AND SWORN TO before me this 7th day of September, 1960

My commission expires July 21, 1962 [Signature] Notary Public.

cc - Sinclair Oil & Gas Co.
 P.O. Box 521
 Tulsa, Oklahoma
 Att: Mr. C. S. Rose

LARIO OIL & GAS CO. ET AL
 No. 2 Earl Moore
 NE NE NW Sec. 1-29S-14W
 Pratt County, Kansas

Drilling Commenced: 9-1-54
 Drilling Completed: 9-21-54
 Well Completed: 10-13-54
 Drilling Contractor: Buick Drilling, Inc.
 Total Depth - 4653' P.B. to 4622'
 I.P. - Physical Pump 113 oil plus 10% Water

Casing Record:
 8 5/8" 371'6" (over all) set at 365'
 Cem. w/ 250 sacks
 5 1/2" 4653' (thds. off) Set at 4650'
 Cem. 175 sacks

Formation	Depth
Sub soil, clay & sand	110
Sand & gravel	240
Clay & sand	250
Red bed	365
Red bed & shells	575
Red bed & shale	813
Anhydrite	843
Red bed & shells	1250
Shale, shells & salt	1485
Shale & shells	1930
Shale & lime	2514
Broken lime	2585
Lime & shale	3515
Lime	3565
Lime & shale	3645
Lime	3715
Lime & shale	3983
Lime	4075
Lime & shale	4155
Lime	4181
Lime & shale	4250
Lime	4295
Lime & shale	4320
Lime	4348
Lime & shale	4450
Lime chert	4480
Cherty lime & shale	4540
Lime & shale	4565
Lime, sand & shale	4600
Lime & shale	4653

Geological Tops:	Elevation	1987 DF	1989 RB
Heebner		3790	-1801
Toronto		3811	-1822
Base Oread		3833	-1844
Douglas Sd.		3912	-1923
Brown Lm.		3965	-1976
Lansing		3985	-1996
Marmaton		4311	-2322
Conglomerate		4458	-2469
Viola		4487	-2498
Simpson Sdy Sh		4524	-2535
Simpson Sd		4530	-2541
Arbuckle		4636	-2647
Schlumberger T.D.		4653	-2664
Rotary T.D.		4653	-2664

I hereby certify that this is a true and correct log of the above mentioned well.

STATE OF KANSAS)
) SS
 COUNTY OF SEDGWICK)

Subscribed and sworn to before me, a Notary Public, in and for said County and State this 3rd day of November, 1954.

Frances Reske
 Notary Public

My Commission expires July 21, 1958.

RECEIVED
 STATE CONSERVATION COMMISSION

JUL 13 1960

CONSERVATION DIVISION
 Wichita, Kansas

Welex perforated 78 shots from 4530-4543
 Acidized 500 gallons mud acid and 500 gallons wash acid
 Sandfrac (Dowell) with 7500# sand and 7500 gallons lease oil