


STATE OF KANSAS  
STATE CORPORATION COMMISSION  
200 Colorado Derby Bldg.  
Wichita, Kansas 67202

Form CP-4  
Rev. 12-15-80

WELL PLUGGING RECORD

Give All Information Completely  
Make Required Affidavit

COUNTY Pratt SEC. 36 TWP. 29S RGE. 13W E/W  
Location as in quarters or footage from lines:  
90' SE of NE/4 SW/4 SE/4

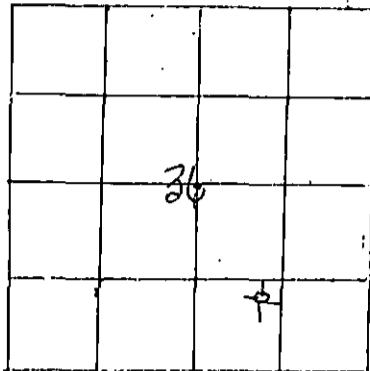

Lease Owner Carl Todd  
Lease Name Blankenship Well No. 1-36  
Office Address 1117 West River Blvd., Wichita, Kansas 67203  
Character of Well (Completed as Oil, Gas or Dry Hole): D & A  
Date Well Completed December 15, 1981  
Application for plugging filed December 15, 1981  
Plugging commenced December 15, 1981  
Plugging completed December 15, 1981  
Reason for abandonment of well or producing formation D & A

Locate Well  
correctly on above  
Section Platt.

Was permission obtained from the Conservation Division or it's  
Agent's before plugging was commenced? Yes

Name of Conservation Agent who supervised plugging of this well Maurice Leslie  
Producing formation \_\_\_\_\_ Depth to top \_\_\_\_\_ bottom \_\_\_\_\_ T.D. 2,880'  
Show depth and thickness of all water, oil and gas formations.

OIL, GAS OR WATER RECORDS

Casing Record

Formation	Content	From	To	Size	Put in	Pulled Out
				8 5/8"	201.37'	-0-

Describe in detail the manner in which the well was plugged, indicating where the mud fluid was placed and the method or methods used in introducing it into the hold. If cement or other plugs were used, state the character of same and depth placed, from \_\_\_\_\_ feet to \_\_\_\_\_ feet for each plug set.

Plugged hole  
Mud to 620' w/60 sx cement  
Mud to 200' w/40 sx cement  
Mud to 40' w/1/2 sx hulls, plug & 10 sx cement  
10 sx cement in Rathole  
Allied Cementing Co.  
Common Cement, 2% Gel, 3% C.C.

(If additional description is necessary, use BACK of this sheet)

Name of Plugging Contractor Red Tiger Drilling Company  
1720 KSB Building, Wichita, Ks. 67202

STATE OF Kansas COUNTY OF Sedgwick, ss.

Carl Todd (~~employee of owner~~) (~~owner~~) of the above-described well, being first duly sworn on oath, says: That I have knowledge of the facts, statements, and matters herein contained and the log of the above-described well as filed and that the same are true and correct. So help me God.

(Signature) Carl Todd  
1117 West River Blvd.  
(Address)

SUBSCRIBED AND SWORN TO before me this 6th day of January, 19 82

T.G. Wright  
Notary Public.

My Commission expires: 11-12-82

T.G. WRIGHT



Red  
01-06-82