

This form shall be filed in duplicate with the Kansas Corporation Commission, 200 Colorado Derby Building, Wichita, Kansas 67202, within ten days after the completion of the well, regardless of how the well was completed.

Attach separate letter of request if the information is to be held confidential. If confidential, only file one copy. Information on side one will be of public record and side two will then be held confidential.

Circle one: Oil, Gas, (Dry) SWD, OWWO, Injection. Type and complete ALL sections. Applications must be filed for dual completion, commingling, SWD and injection, T.A.

Attach wireline logs (i.e. electrical log, sonic log, gamma ray neutron log, etc.). KCC # (316) 263-3238. (Rules 82-2-105 & 82-2-125)

OPERATOR Mid-Continent Energy Corporation

API NO. 15-185-21,644-0000

ADDRESS 120 S. Market, Suite #712
Wichita, KS 67202

COUNTY Stafford
FIELD Wildcat

**CONTACT PERSON Larry P. Schneider
PHONE (316) 265-9501

PROD. FORMATION N/A

PURCHASER N/A

LEASE Harrison


ADDRESS

WELL NO. #1

DRILLING Blue Goose Drilling
CONTRACTOR
ADDRESS P.O. Box 1413
Great Bend, KS 67530

WELL LOCATION 100'S NW 1/4 SE 1/4 SW 1/4
990 Ft. from FEL Line and
890 Ft. from FSL Line of
the SW 1/4 SEC. 23 TWP. 25 RGE. 13W

WELL FLAT

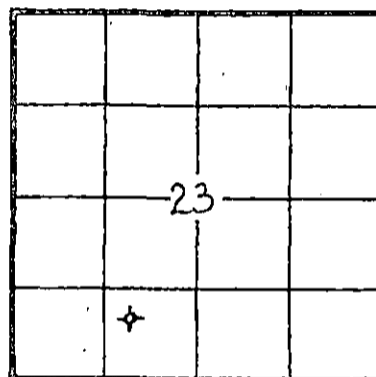

KCC
KGS
(Office Use)

PLUGGING Same as above
CONTRACTOR
ADDRESS

TOTAL DEPTH 4325' PBD N/A

SPUD DATE 8-10-82 DATE COMPLETED 8-19-82

ELEV: GR 1920' DF 1925' KB 1927'

DRILLED WITH (X) (ROTARY) (X) TOOLS

Amount of surface pipe set and cemented 362', 8 5/8". DV Tool Used?

A F F I D A V I T

STATE OF Kansas, COUNTY OF Sedgwick SS, I,

Larry P. Schneider OF LAWFUL AGE, BEING FIRST DULY SWORN UPON HIS OATH,
DEPOSES THAT HE IS Exploration Manager (FOR) Mid-Continent Energy Corporation
OPERATOR OF THE Harrison LEASE, AND IS DULY AUTHORIZED TO MAKE

THIS AFFIDAVIT FOR AND ON THE BEHALF OF SAID OPERATOR, THAT WELL NO. #1 ON
SAID LEASE HAS BEEN COMPLETED AS OF THE 19th DAY OF August, 19 82, AND THAT
STATE CORPORATION COMMISSION
ALL INFORMATION ENTERED HEREIN WITH RESPECT TO SAID WELL IS TRUE AND CORRECT.

FURTHER AFFIANT SAITH NOT. 8-23-82

CONSERVATION DIVISION
Wichita, Kansas

(S) [Signature]

SUBSCRIBED AND SWORN BEFORE ME THIS 20th DAY OF August, 19 82

JACK N. BUEHLER
NOTARY PUBLIC
STATE OF KANSAS
My Appt. Expires 3-23-85

[Signature] NOTARY PUBLIC

MY COMMISSION EXPIRES:

**The person who can be reached by phone regarding any questions concerning this information. Within 45 days of completion, a witnessed initial test by the Commission is required if the well produces more than 25 BOPD or is located in a Basic Order Pool.

SIDE TWO

WELL LOG

Show all important zones of porosity and contents thereof; cored intervals, and all drill-stem tests, including depth interval tested, cushion used, time tool open, flowing and shut-in pressures, and recoveries.

SHOW GEOLOGICAL MARKERS, LOGS RUN, OR OTHER DESCRIPTIVE INFORMATION.

FORMATION DESCRIPTION, CONTENTS, ETC.	TOP	BOTTOM	NAME	DEPTH
DST #1: Simp. Sd. 4270'-4290'. 45-45-60-60 interval. Wk. blow throughout. Rec. 25' SOGCM, 300' SGCMW. FP=45-84, 60-169. DIP=1227-1195. BHT=120°.			Heebner	3510' -1583
			Lansing	3692' -1765
			BKC	3981' -2054
			Mississippi	4142' -2215
			Viola	4181' -2254
			Simpson Sand	4271' -2344
			L.T.D.	4323 -2396

RELEASED
SEP 01 1967
FROM CONFIDENTIAL

Report of all strings set — surface, intermediate, production, etc. CASING RECORD (New) or (Used)

Purpose of string	Size hole drilled	Size casing set (in O.D.)	Weight lbs/ft.	Setting depth	Type cement	Sacks	Type and percent additives
Surface Csg.		8 5/8"	20#	369'	Common	250	3% CC, 2% gel

LINER RECORD

PERFORATION RECORD

Top, ft.	Bottom, ft.	Sacks cement	Shots per ft.	Size & type	Depth interval
N/A					
TUBING RECORD			N/A		
Size	Setting depth	Packer set at			
N/A					

ACID, FRACTURE, SHOT, CEMENT SQUEEZE RECORD

Amount and kind of material used	Depth interval treated
N/A	

Date of first production	Producing method (flowing, pumping, gas lift, etc.)	Gravity		
N/A	N/A	N/A		
RATE OF PRODUCTION PER 24 HOURS	Oil	Gas	Water	Gas-oil ratio
	N/A	N/A	% N/A	N/A
Position of gas (vented, used on lease or sold)		MCF	bbis.	CFPB
N/A				
Perforations			N/A	