

REVISED PLUGGING RECORD
Originally Filed November 3, 1975


FORM CP-4

STATE OF KANSAS
STATE CORPORATION COMMISSION
CONSERVATION DIVISION
P. O. BOX 17027
WICHITA, KANSAS 67217

WELL PLUGGING RECORD

Stafford County, Sec. 20 Twp. 25 Rge. 13 (E) (W)X

Location as "NE/CNW/SW" or footage from lines SW/NE/NW
Lease Owner Woodman-Iannitti Drilling Co.
Lease Name GARNER Well No. 1
Office Address P. O. Box 308, Great Bend, Kansas 67530
Character of Well (completed as Oil, Gas or Dry Hole) _____
Date well completed _____ 19____
Application for plugging filed _____ 19____
Application for plugging approved _____ 19____
Plugging commenced _____ October 20, 19 75
Plugging completed _____ October 30, 19 75
Reason for abandonment of well or producing formation Depleted

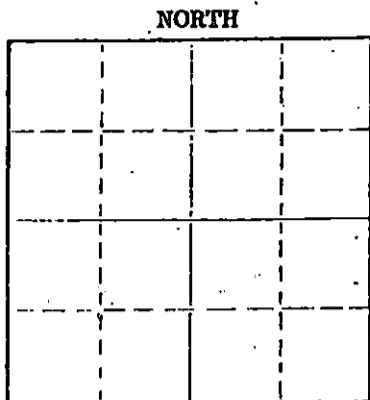

Locate well correctly on above Section Plat

If a producing well is abandoned, date of last production _____ 19____
Was permission obtained from the Conservation Division or its agents before plugging was commenced? Yes

Name of Conservation Agent who supervised plugging of this well G. R. Biberstein
Producing formation _____ Depth to top _____ Bottom _____ Total Depth of Well 4389 Feet
Show depth and thickness of all water, oil and gas formations.

OIL, GAS OR WATER RECORDS

CASING RECORD

FORMATION	CONTENT	FROM	TO	SIZE	PUT IN	PULLED OUT
				8 5/8	321	-0-
				5 1/2	4380	3716.90

Describe in detail the manner in which the well was plugged, indicating where the mud fluid was placed and the method or methods used in introducing it into the hole. If cement or other plugs were used, state the character of same and depth placed, from _____ feet to _____ feet for each plug set.


Plugged bottom back to 4000' with sand and 5 sack cement.
Shot casing at 3710'. Spotted oil. Pulled a total of 118
joints of 5 1/2" casing. Plugged well with 3 sacks hulls,
10 sacks gel and 100 sacks 50/50 Pozmix. Ran 1" tubing and
plugged well to surface with 35 sacks cement.

JAN 20 1976
1-29-76
WICHITA, KANSAS

(If additional description is necessary, use BACK of this sheet)
Name of Plugging Contractor Rockhold Engineering, Inc.
Address P. O. Box 698, Great Bend, Kansas 67530

STATE OF Kansas COUNTY OF Barton
James W. Rockhold (employee of owner) or (owner or operator) of the above-described

well, being first duly sworn on oath, says: That I have knowledge of the facts, statements, and matters herein contained and the log of the above-described well as filed and that the same are true and correct. So help me God.

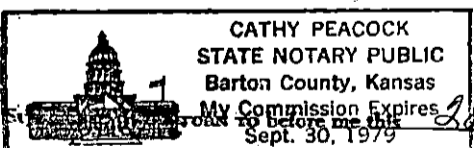

(Signature) James W. Rockhold
Box 698, Great Bend, Kansas 67530

(Address) January 19 76
Cathy Peacock
Cathy Peacock Notary Public

My commission expires September 30, 1979

State Corporation Commission
Conservation Division
245 North Water
Wichita, Kansas 67202