


STATE OF KANSAS
STATE CORPORATION COMMISSION

Form CP-4

Give All Information Completely
Make Required Affidavit
Mail or Deliver Report to:
Conservation Division
State Corporation Commission
212 No. Market
Wichita, Kansas

WELL PLUGGING RECORD

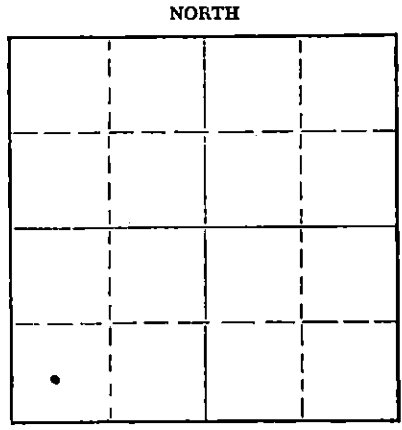

Locate well correctly on above Section Plat

Stafford County, Sec. 20 Twp. 25 Rge. 13 (E) W (W)
Location as "NE/CNW/SW" or footage from lines SE SW NE
Lease Owner Chief Drilling Company
Lease Name Kipp Well No. 3
Office Address Great Bend, Kansas
Character of Well (completed as Oil, Gas or Dry Hole)
Date well completed 19
Application for plugging filed 19
Application for plugging approved 19
Plugging commenced 6/5/67 19
Plugging completed 6/12/67 19
Reason for abandonment of well or producing formation depleted.
If a producing well is abandoned, date of last production 19
Was permission obtained from the Conservation Division or its agents before plugging was commenced? yes

Name of Conservation Agent who supervised plugging of this well Archie Elving
Producing formation Depth to top Bottom Total Depth of Well 4442 Feet
Show depth and thickness of all water, oil and gas formations.

OIL, GAS OR WATER RECORDS

CASING RECORD

FORMATION	CONTENT	FROM	TO	SIZE	PUT IN	PULLED OUT
				10-3/4"	290'	none
				7"	4396'	2113'

Describe in detail the manner in which the well was plugged, indicating where the mud fluid was placed and the method or methods used in introducing it into the hole. If cement or other plugs were used, state the character of same and depth placed, from feet to feet for each plug set.

Checked hole to 4442', ran plug to 4250', shot cement in cellar. Ran sand to 4200', ran 7 sacks of cement. Shot pipe at 3451', wroked pipe to 18" tension. Shot at 3268', 3082', 2883', 2693', 2600', 2496', 2398', 2299', 2204', 2100', worked pipe loose. Ran rock in hole and bridged at 120'. Pumped 10 sacks gel and 100 sacks of cement. Tallied pipe.

PLUGGING COMPLETE.

RECEIVED
STATE CORPORATION COMMISSION
JUL 31 1967
7-31-67
CONSERVATION DIVISION
WICHITA, KANSAS

(If additional description is necessary, use BACK of this sheet)

Name of Plugging Contractor KNIGHT CASING PULLING COMPANY
Address CHASE, KANSAS

STATE OF KANSAS, COUNTY OF RICE, ss. NOEL J. KNIGHT

(employee of owner) or (owner or operator) of the above-described well, being first duly sworn on oath, says: That I have knowledge of the facts, statements, and matters herein contained and the log of the above-described well as filed and that the same are true and correct. So help me God.

(Signature) [Handwritten Signature]
CHASE, KANSAS
(Address)

SUBSCRIBED AND SWORN to before me this 14th day of June, 19 67

[Handwritten Signature] Notary Public.

My commission expires February 15, 1971

WELL LOG

Chief Drilling Co., Inc., etal
P. O. Box 77
Great Bend, Kansas

No. 3 Kipp
SE SW NE Sec. 20-25S-13W
Stafford County, Kansas

Contractor: Chief Drilling Co., Inc.

Commenced: 1-20-61
Completed: 2-7-61

Casing Record: 10-3/4" @ 290' cemented with 285 sacks Sunset Cement
7" @ 4396' cemented with 166 sacks cement

<u>FORMATION</u>	<u>FROM</u>	<u>TO</u>	<u>ELEVATION</u>
Sand and Shale	0	200'	1953' Gr.
Shale	200'	245'	1955' D.F.
Hard Sand and Iron Pyrite	245'	265'	1958' K.B.
Shale and Shells	265'	290'	
Shale and Shells and Redbed	290'	828'	
Anhydrite	828'	848'	
Shale and Shells	848'	1820'	
Shale and Lime	1820'	1850'	
Lime and Shale	1850'	2075'	
Lime	2075'	2210'	
Lime and Shale	2210'	2540'	
Shale with Lime Streaks	2540'	2670'	
Shale and Lime	2670'	2890'	
Lime and Shale	2890'	2950'	
Lime	2950'	2990'	
Lime and Shale	2990'	3215'	
Shale and Lime	3215'	3325'	
Lime	3325'	3537'	
Lime and Shale	3537'	3717'	
Lime	3717'	3997'	
Lime and Shale	3997'	4080'	
Chert and Shale	4080'	4100'	
Shale	4100'	4158'	
Chert and Lime	4158'	4258'	
Lime	4258'	4276'	
Shale	4276'	4281'	
Sand	4281'	4310'	
Shale	4310'	4340'	
Dolomite	4340'	4442'	
Total Depth	4442'		

<u>FORMATION TOPS</u>	
Anhydrite	828' (+1130)
Heebner	3537' (-1579)
Brown Lime	3685' (-1727)
Lansing	3717' (-1759)
Base Kansas City	3997' (-2039)
Mississippi	4080' (-2122)
Viola	4158' (-2200)
Simpson Shale	4276' (-2318)
Simpson Sand	4281' (-2323)
Arbuckle	4340' (-2382)
Total Depth	4442' (-2484)

STATE OF KANSAS, COUNTY OF BARTON) SS.

I hereby certify that the above is a true and correct copy of the Driller's Log of the well drilled in the SE SW NE Sec. 20-25S-13W, Stafford County, Kansas, to the best of my knowledge and belief.

CHIEF DRILLING CO., INC.

V. Richard Hoover
V. Richard Hoover, President

Subscribed and sworn to before me this 7th day of February, 1961.

My commission expires: October 3, 1964.

Helen E. Fischer
Helen E. Fischer, Notary Public