


STATE OF KANSAS
STATE CORPORATION COMMISSION

WELL PLUGGING RECORD

Give All Information Completely
Make Required Affidavit
Mail or Deliver Report to
Conservation Division
State Corporation Comm.
245 North Water
Wichita, KS 67202

Stafford County, Sec. 20 Twp. 25S Rge. 13 E/W
Location as "NE/CNW $\frac{1}{4}$ SW $\frac{1}{4}$ " or footage from lines

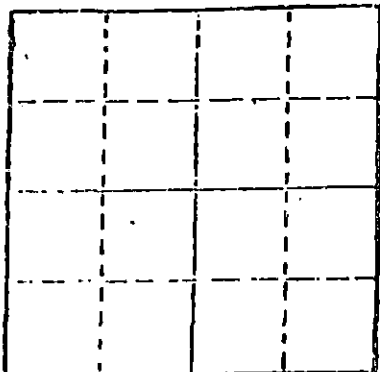

Locate well correctly on above
Section Plot

SE NW SE
Lease Owner Centennial Petroleum, Inc.
Lease Name Curtis 'A' Well No. 1
Office Address Suite 1415, Denver Club Bldg., 518 17th St.
Character of Well (Completed as Oil, Gas or Dry Hole)
Dry Hole Denver, CO. 80202

Date Well completed 3-22 1981
Application for plugging filed 3-22 1981
Application for plugging approved 3-22 1981
Plugging commenced 3-22 1981
Plugging completed 3-23 1981
Reason for abandonment of well or producing formation

Dry Hole
If a producing well is abandoned, date of last production 19

Was permission obtained from the Conservation Division or its agents before plugging was commenced? yes

Name of Conservation Agent who supervised plugging of this well William T. Owen
Producing formation Depth to top Bottom Total Depth of Well
Show depth and thickness of all water, oil and gas formations.

OIL, GAS OR WATER RECORDS

CASING RECORD

FORMATION	CONTENT	FROM	TO	SIZE	PUT IN	PULLED OUT
				8 5/8"	294'	-0-

Describe in detail the manner in which the well was plugged, indicating where the mud fluid was placed and the method or methods used in introducing it into the hole. If cement or other plugs were used, state the character of same and depth placed, from feet to feet for each plug set.

Mud laden fluid 4390' - 520'
40 sks cement @ 520'
30 sks cement @ 280'
10 sks cement @ 40'
10 sks cement in rat hole

RECEIVED
STATE CORPORATION COMMISSION

MAR 26 1981

3-26-81
CONSERVATION DIVISION
Wichita, Kansas

(If additional description is necessary, use BACK of this sheet)

Name of Plugging Contractor Emphasis Oil Operations

STATE OF KANSAS COUNTY OF RUSSELL, ss.
Don Favinger (employee of owner) or (owner or operator)
of the above-described well, being first duly sworn on oath, says: That I have knowledge of the facts, statements, and matters herein contained and the log of the above-described well as filed and that the same are true and correct. So help me God.

(Signature) *Don Favinger*
P. O. Box 506, Russell, KS 67665
(Address)

SUBSCRIBED AND SWORN TO before me this 24th day of March, 19 81.

My commission expires February 6, 1984.

Glenda R. Tiffin
Glenda R. Tiffin Notary Public.



EMPHASIS OIL OPERATIONS

P. O. Box 506

Russell, Kansas 67665

DRILLERS LOG

OPERATOR: Centennial Petroleum, Inc.
Suite 1415, Denver Club Building
518 17th Street
Denver, Colorado 80202

CONTRACTOR: Emphasis Oil Operations
P. O. Box 506
Russell, Kansas 67665

LEASE: Curtis 'A' WELL: #1

LOCATION: SE NW SE
Section 20-25S-13W
Stafford County, Kansas

Total Depth: 4390'

Elevation:

Commenced: 3-11-81

Completed: 3-22-81

Casing: 8 5/8" @ 294' with 250 sks cement

Status: Dry Hole

DEPTHS & FORMATIONS

(All measurements from K.B.)

Sand & top soil	40'	Lime	4097'
Sand & shale	850'	Shale & lime	4189'
Shale	2448'	Lime	4304'
Shale & lime	3095'	Simpson sand	4327'
Shale	3766'	Lime & shale	4388'
Lime & shale	3996'	Lime (R.T.D.)	4390'


RECEIVED
STATE CORPORATION COMMISSION

MAR 26 1981

CONSERVATION DIVISION
Wichita, Kansas

STATE OF KANSAS)
) ss:
COUNTY OF RUSSELL)

I, Don Favinger, of Emphasis Oil Operations, state that the above and foregoing is a true and correct log of the above captioned well.

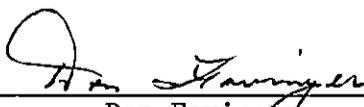

Don Favinger

Subscribed and sworn to before me this 24th day of March, 1981.

My Commission Expires: February 6, 1984.

 **GLEND A. R. TIFFIN**
Russell County, Ks.
My Appt. Exp. 2-6-84



Notary Public