


STATE OF KANSAS
STATE CORPORATION COMMISSION

Give All Information Completely
Make Required Affidavit
Mail or Deliver Report to:
Conservation Division
State Corporation Commission
212 North Market, Insurance Bldg.
Wichita, Kansas

WELL PLUGGING RECORD

NORTH

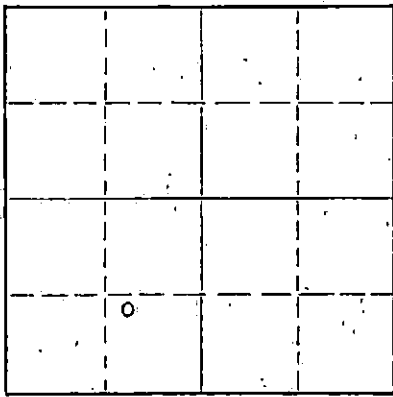

Locate well correctly on above
Section Plat

Stafford County, Sec. 21 Twp. 25S Rge. 13 (W)
Location as "NE/CNW/SW" or footage from lines NW SE SW
Lease Owner: Alva Oil Corporation, Inc.
Lease Name: McCandless Well No. 1
Office Address: 510 Fourth National Building, Wichita, Kansas
Character of Well (completed as Oil, Gas or Dry Hole) Dry hole
Date well completed September 5, 1959
Application for plugging filed September 5, 1959
Application for plugging approved September 5, 1959
Plugging commenced September 5, 1959
Plugging completed September 5, 1959
Reason for abandonment of well or producing formation Dry hole

If a producing well is abandoned, date of last production 19
Was permission obtained from the Conservation Division or its agents before plugging was commenced? Yes

Name of Conservation Agent who supervised plugging of this well W. L. Lackamp
Producing formation Depth to top Bottom Total Depth of Well 4426 Feet
Show depth and thickness of all water, oil and gas formations.

OIL, GAS OR WATER RECORDS

CASING RECORD

FORMATION	CONTENT	FROM	TO	SIZE	PUT IN	PULLED OUT
				8 5/8"	362	None

Describe in detail the manner in which the well was plugged, indicating where the mud fluid was placed and the method or methods used in introducing it into the hole. If cement or other plugs were used, state the character of same and depth placed, from feet to feet for each plug set.

Filled hole from total depth, 4426, to 316' with mud. Cement plug from 316' to 250' with 20 sx cement. Mud from 250' to 73'. Cement plug from 73' to 40' with 10 sx. cement. Heavy rotary mud from 40' to cellar.

RECEIVED
STATE CORPORATION COMMISSION
SEP 14 1959
CONSERVATION DIVISION
Wichita, Kansas

(If additional description is necessary, use BACK of this sheet)

Name of Plugging Contractor National Drilling Company, Inc.
Address 535 Petroleum Building, Wichita, Kansas

STATE OF KANSAS, COUNTY OF SEDGWICK ss.
Howard A. Stoskopf Contractor
well, being first duly sworn on oath, says: That I have knowledge of the facts, statements, and matters herein contained and the log of the above-described well as filed and that the same are true and correct. (So help me God.)

(Signature)

Howard A. Stoskopf
535 Petroleum Building, Wichita, Kansas
(Address)

SUBSCRIBED AND SWORN to before me this 9th day of September, 1959

My commission expires

Notary Public.

RUBY GOURLEY

My commission expires July 13, 1960

PLUGGING

File Sec. 21 T. 25 R. 13W

Book Page 3 Line 8

DRILLERS LOG

McCandless #1

CASING RECORD: 8 5/8" at 360'
w/300 sx Sunset

COMPANY: Alva Oil Corporation, Inc.

CONTRACTOR: National Drilling Company, Inc.

COMMENCED: August 24, 1959

COMPLETED: September 5, 1959

DESCRIPTION: NW SE SW
21-25S-13W
Stafford County
Kansas

ELEVATION: 1945 KB
1943 DF

TOTAL DEPTH: 4432 (-2487)

<u>FORMATION</u>	<u>FROM</u>	<u>TO</u>	<u>REMARKS</u>
Sand	0	190	
Shale	190	225	
Redbed	225	360	
Shale & Shells	360	490	
Red Shale	490	840	
Anhydrite	840	885	
Shale	885	1125	
Shale & Shells	1125	1820	
Lime & Shale	1820	1890	
Lime	1890	2060	
Lime & Shale	2060	2645	
Shale & Lime	2645	3310	
Lime & Shale	3310	3390	
Lime	3390	3460	
Lime & Shale	3460	3690	
Lime	3690	4180	
Cherty Lime	4180	4228	
Lime & Chert	4228	4270	
Lime	4270	4315	
Chert	4315	4339	
Lime	4339	4390	
Lime & Chert	4390	4432	

RECEIVED
STATE CORPORATION COMMISSION
NOV 25 1959
CONSERVATION DIVISION
Wichita, Kansas

I certify that this is a true and correct copy of the above log to the best of my knowledge.

NATIONAL DRILLING COMPANY, INC.

Howard A. Stoskopf

Subscribed and sworn to before me this 9th day of September, 1959.

Notary Public

RUBY GOURLEY

My commission expires July 13, 1960