


STATE OF KANSAS  
STATE-CORPORATION COMMISSION

WELL PLUGGING RECORD

Give All Information Completely  
Make Required Affidavit  
Mail or Deliver Report to:  
Conservation Division  
State Corporation Commission  
212 North Market, Insurance Bldg.  
Wichita, Kansas

Stafford County. Sec. 17 Twp. 25 Rge. 13 (W)  
Location as "NE/CNW/SW" or footage from lines NE NE NW  
Lease Owner D. R. Lauck Oil Company, Inc.  
Lease Name Lyons Well No. 1  
Office Address 301 South Broadway, Wichita, Kansas  
Character of Well (completed as Oil, Gas or Dry Hole) Oil  
Date well completed July 27 1959  
Application for plugging filed March 20 1961  
Application for plugging approved March 24 1961  
Plugging commenced March 29 1961  
Plugging completed April 3 1961  
Reason for abandonment of well or producing formation Production Depleted

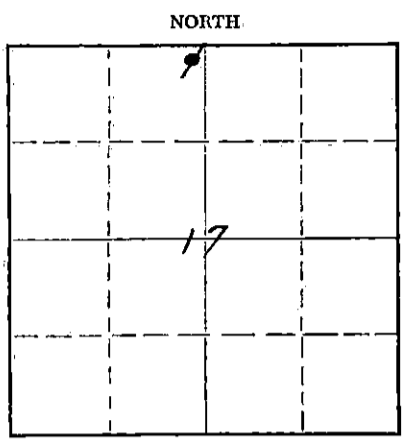

Locate well correctly on above Section Plat

If a producing well is abandoned, date of last production March 25 1961  
Was permission obtained from the Conservation Division or its agents before plugging was commenced? Yes

Name of Conservation Agent who supervised plugging of this well Mr. Frank Broadfoot  
Producing formation Mississippi Depth to top 4020 Bottom 4130 Total Depth of Well 4323 Feet  
Show depth and thickness of all water, oil and gas formations. 4245 PB

OIL, GAS OR WATER RECORDS				CASING RECORD		
FORMATION	CONTENT	FROM	TO	SIZE	PUT IN	PULLED OUT
				8 5/8	321	None
				5 1/2	4323	3635
Mississippi	Oil	4020	4130			
Arbuckle	Dry	4296	4323			

Describe in detail the manner in which the well was plugged, indicating where the mud fluid was placed and the method or methods used in introducing it into the hole. If cement or other plugs were used, state the character of same and depth placed, from \_\_\_\_\_ feet to \_\_\_\_\_ feet for each plug set.

Sand	4245 - 4000
5 Sx. Cement	4200 - 3940
Mud	3940 - 250
Rock	250 - 240
15 Sx. Cement	240 - 180
Mud	180 - 40
Rock & 10 Sx. Cement	40 - Cellar base

RECEIVED  
STATE CORPORATION COMMISSION

APR 7 1961

CONSERVATION DIVISION  
Wichita, Kansas

4-7-61

(If additional description is necessary, use BACK of this sheet)  
Name of Plugging Contractor Glenn & Smith Pipe Pulling Company Permit # 396  
Address P. O. Box 114, Ellinwood, Kansas

STATE OF Kansas COUNTY OF Barton, ss.  
H. E. Wolfe (employee of owner) or (owner or operator) of the above-described well, being first duly sworn on oath, says: That I have knowledge of the facts, statements, and matters herein contained and the log of the above-described well as filed and that the same are true and correct. So help me God.

(Signature) [Signature]  
P. O. Box 488 Ellinwood Kansas (Address)

SUBSCRIBED AND SWORN TO before me this 5th day of April, 1961  
Catherine Hannicke Notary Public.

My Commission Expires April 6, 1963  
My commission expires \_\_\_\_\_