


STATE OF KANSAS
STATE CORPORATION COMMISSION

WELL PLUGGING RECORD

Give All Information Completely
Make Required Affidavit
Mail or Deliver Report to:
Conservation Division
State Corporation Commission
800 Bittling Building
Wichita, Kansas

Stafford County, Sec. 17 Twp. 25S. Rge. 13 (E) (W)
Location as "NE/CNW $\frac{1}{4}$ SW $\frac{1}{4}$ " or footage from lines NW, NW, NW
Lease Owner The El Dorado Refining Company
Lease Name Lyons Well No. 2
Office Address Box 209 - Russell, Kansas
Character of Well (completed as Oil, Gas or Dry Hole) Oil
Date well completed October 17 1955
Application for plugging filed October 10 1956
Application for plugging approved October 12 1956
Plugging commenced October 23 1956
Plugging completed November 3 1956
Reason for abandonment of well or producing formation Insufficient Production

NORTH

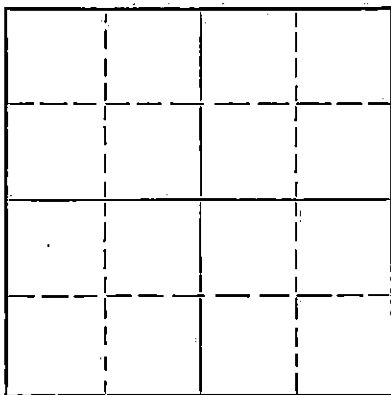

Locate well correctly on above
Section Plat

Name of Conservation Agent who supervised plugging of this well Mr. E. M. Brundage - Box 283 - Hoisington, Kansas
Producing formation Arbuckle Depth to top 1281 Bottom 1292 Total Depth of Well 1291 Feet
Show depth and thickness of all water, oil and gas formations.

OIL, GAS OR WATER RECORDS

CASING RECORD

Formation	Content	From	To	Size	Put In	Pulled Out
				8 5/8"	301'	none
				5 1/2"	1281'	2988.20'

Describe in detail the manner in which the well was plugged, indicating where the mud fluid was placed and the method or methods used in introducing it into the hole. If cement or other plugs were used, state the character of same and depth placed, from _____ feet to _____ feet for each plug set.

Filled hole with sand to 3810'

Run 5 sacks of cement at 3810'

Pumped 20 sacks of mud in hole

Pumped 90 sacks of cement in hole

Run 5 sacks of cement to cap.

(If additional description is necessary, use BACK of this sheet)

Name of Plugging Contractor C. E. Shull Casing Pulling Company
Address Box 558 - Great Bend, Kansas

STATE OF KANSAS, COUNTY OF RUSSELL, ss.
VERREL J. BRACK (employee of owner) or (owner or operator) of the above-described well, being first duly sworn on oath, says: That I have knowledge of the facts, statements, and matters herein contained and the log of the above-described well as filed and that the same are true and correct. So help me God.

(Signature) Verrel J. Brack
Box 209 - Russell, Kansas (Address)

SUBSCRIBED AND SWORN to before me this 13th day of November, 1956.

Carol J. Bennett Notary Public.

My commission expires October 2, 1960

23-8390-3 6-51-20M
PLUGGING
FILE SEC. 17 T. 25 R. 13W
BOOK PAGE 107 L. E. 2

RECEIVED
STATE CORPORATION COMMISSION
NOV 14 1956 11-14-56
CONSERVATION DIVISION
Wichita, Kansas

ROTARY DRILLING LOG

OPERATOR: El Dorado Refining Co.
 Lyons #2
 NW NW Sec. 17-25-13W
 Stafford County, Kansas

CONTRACTOR: Prime Drilling Company
 COM: 10/17/55
 COMP: 10/17/55

Formations:

Surface sand & clay	40'
Sand	160'
Shale & Red Rock	220'
Lime & Shale	304'
Red Bed	812'
Anhydrite	845'
Shale	910'
Shale & Red Bed	1250'
Shale & Shells	1470'
Shale & Lime	2005'
Lime	2215'
Lime & Shale	2500'
Shale with lime streaks	2600'
Shale & Lime	3415'
Lime	3515'
Lime & Shale	3655'
Lime	4055'
Lime & Shale	4104'
Lime, Shale & Chert	4115'
Viola Chert	4155'
Lime Cherty	4211'
Lime & Chert	4240'
Lime, Shale, Sand Chert	4275'
Lime	4292'
Rotary Total Depth	4292'

Remarks: Set 8 5/8" surface casing at 304' with 250 sacks common cement, 2% C. C.

TOPS

Heebner Shale	3504
Toronto LS	3523
Douglas Sh	3546
Brown Ls	3653
Lans. Ls	3683
Miss Chert	4036
Kinderhook Sh	4047
Viola Chert	4098
Simp Sh	4224
Simps Sd	4243
arb	4261
RTD	4290
5 1/2" Csg.	4282

Set 5 1/2" casing at 4204' cemented with 125 sacks common cement.

We certify that the above log is true and correct to the best of our knowledge and belief.

PRIME DRILLING COMPANY

R. R. Mcnicol

NOTE: Perforations 3951-59' with 4 holes per foot.
 Plug set at 3850'
 Perforations 3820-26' with 4 holes per foot.
 Plug set at 3980'

PLUGGING
 FILE SEC 17 T. 25 R. 13W
 BOOK PAGE 107 LINE 2

RECEIVED
 STATE COMMISSION
 OCT 17 1955
 CONSERVATION
 WICHITA, KANSAS