


WELL PLUGGING RECORD

Give All Information Completely
Make Required Affidavit
Mail or Deliver Report to:
Conservation Division
State Corporation Commission
211 No. Broadway
Wichita, Kansas

Stafford County, Sec. 17 Twp. 25 Rge. 13 (E) (W) x

NORTH

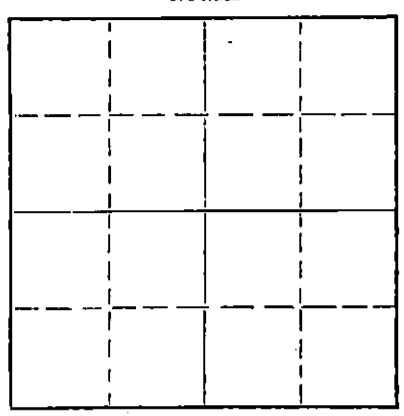

Locate well correctly on above
Section Plat

Location as "NE/CNW/SE/SW" or footage from lines SE SE SW
Lease Owner Woodman-Iannitti Oil Co.
Lease Name Garner Well No. #1
Office Address Box 387 Hoisington, Kansas
Character of Well (completed as Oil, Gas or Dry Hole)
Date well completed 19
Application for plugging filed 10-10-64 19
Application for plugging approved 19
Plugging commenced 10-12-64 19
Plugging completed 10-16-64 19
Reason for abandonment of well or producing formation

If a producing well is abandoned, date of last production 19
Was permission obtained from the Conservation Division or its agents before plugging was commenced? Yes

Name of Conservation Agent who supervised plugging of this well Herman Justus
Producing formation Depth to top Bottom Total Depth of Well 4357' Feet
Show depth and thickness of all water, oil and gas formations.

OIL, GAS OR WATER RECORDS

CASING RECORD

FORMATION	CONTENT	FROM	TO	SIZE	PUT IN	PULLED OUT
						3216.69'

Describe in detail the manner in which the well was plugged, indicating where the mud fluid was placed and the method or methods used in introducing it into the hole. If cement or other plugs were used, state the character of same and depth placed, from feet to feet for each plug set.

Plug back with sand to 4200', mixed and ran 5 sacks cement thru dump baler.
Squeezed hole with 20 sacks gel and 75 sacks cement.

RECEIVED
STATE CORPORATION COMMISSION

10-19-64 OCT 19 1964

CONSERVATION DIVISION
Wichita, Kansas

(If additional description is necessary, use BACK of this sheet)

Name of Plugging Contractor Southwest Casing Pulling Co., Inc.
Address Box 364, Great Bend, Kansas

STATE OF Kansas, COUNTY OF Barton, ss.
Southwest Casing Pulling Co., Inc. (employee of owner) or (owner or operator) of the above-described well, being first duly sworn on oath, says: That I have knowledge of the facts, statements, and matters herein contained and the log of the above-described well as filed and that the same are true and correct. So help me God.

(Signature) W.C. Spencer
Box 364, Great Bend, Kansas
(Address)

SUBSCRIBED AND SWORN to before me this 17 day of October, 19 64

My commission expires 24 October 1964
Sidney D. Miller Notary Public.

KANSAS GEOLOGICAL SOCIETY
 KANSAS WELL LOG BUREAU - KANSAS WELL SAMPLE BUREAU
 KANSAS GEOLOGICAL SOCIETY BUILDING
 508 EAST MURDOCK - WICHITA, KANSAS

COMPANY Woodman & Iannitti Drilling Co.

SEC. 17 T. 25 R. 13W

FARM Garner

NO. 1

LOC. SE SE SW

TOTAL DEPTH 4355'

COUNTY Stafford

COMM. 10-11-63


COMP. 10-25-63

KANSAS

SHOT OR TREATED

CONTRACTOR Woodman & Iannitti Drilling Co.

ISSUED

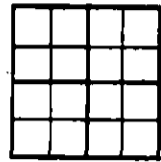

CASING

20 10
 15 8 5/8 @ 337 w/275 sx cement
 12 6
 13 5 1/2 @ 4353 w/75 sx cement

ELEVATION 1956 RB

PRODUCTION

FIGURES INDICATE BOTTOM OF FORMATIONS

0 -	189	Sand
	345	Red Bed
	395	Shale
	775	Red Bed
	820	Sand
	850	Anhydrite
	1250	Shale
	1775	Shale & Shells
	1850	Lime & Shale
	2710	Lime
	2960	Shale & Lime
	3170	Lime
	3395	Lime & Shale
	3805	Lime
	3890	Hard Lime
	4065	Lime
	4080	Lime & Chert
	4155	Lime
	4200	Chert & Shale
	4225	Chert
	4237	Lime & Chert
	4315	Shale
	4339	Lime & Shale
	4355	Arbuckle

RECEIVED
 STATE CORPORATION COMMISSION

NOV 20 1964

CONSERVATION DIVISION
 Wichita, Kansas

I certify the above to be a true and correct copy of the Driller's Log to the best of my knowledge and belief.

WOODMAN & IANNITTI DRILLING CO.

By: K. T. Woodman
 K. T. Woodman