


STATE OF KANSAS
STATE CORPORATION COMMISSION

WELL PLUGGING RECORD

Give All Information Completely
Make Required Affidavit
Mail or Deliver Report to:
Conservation Division
State Corporation Commission
212 North Market, Insurance Bldg.
Wichita, Kansas

Stafford County, Sec. 18 Twp. 25 Rge. 13W (E) (W)

Location as "NE/CNW/SW" or footage from lines SE SW NE
Lease Owner McKnab Production Company, Inc.
Lease Name C. S. Curtis Well No. 1
Office Address Mile High Center, Denver, Colorado
Character of Well (completed as Oil, Gas or Dry Hole) Dry Hole
Date well completed 3-27 19 59
Application for plugging filed 3-27 19 59
Application for plugging approved 3-27 19 59
Plugging commenced 3-27 19 59
Plugging completed 3-27 19 59
Reason for abandonment of well or producing formation _____

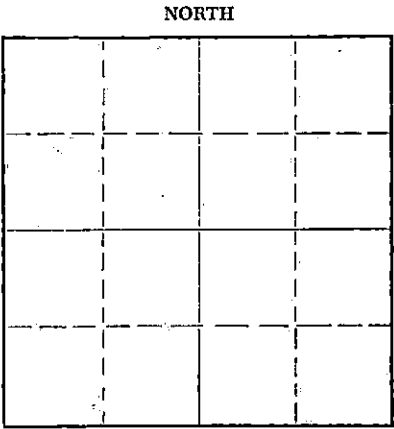

Locate well correctly on above Section Plat

If a producing well is abandoned, date of last production _____ 19 ____
Was permission obtained from the Conservation Division or its agents before plugging was commenced? Yes

Name of Conservation Agent who supervised plugging of this well Frank Broadfoot
Producing formation _____ Depth to top _____ Bottom _____ Total Depth of Well 4325 Feet
Show depth and thickness of all water, oil and gas formations.

OIL, GAS OR WATER RECORDS				CASING RECORD		
FORMATION	CONTENT	FROM	TO	SIZE	PUT IN	PULLED OUT
		0	265	8-5/8	265	none - cement circulated

Describe in detail the manner in which the well was plugged, indicating where the mud fluid was placed and the method or methods used in introducing it into the hole. If cement or other plugs were used, state the character of same and depth placed, from _____ feet to _____ feet for each plug set.

Plug set at 290', cemented with 25 sacks cement, 1/2 sack hulls
Plug set at 35', 1/2 sack hulls, 10 sacks cement to surface

RECEIVED
STATE CORPORATION COMMISSION
APR 1 1959
CONSERVATION DIVISION
Wichita, Kansas

(If additional description is necessary, use BACK of this sheet)
Name of Plugging Contractor Mallonee Drilling Company, Inc.
Address 820 Union Center, Wichita, Kansas

STATE OF KANSAS, COUNTY OF SEDGWICK, ss.
R. E. Mallonee (employee of owner) or (owner or operator) of the above-described well, being first duly sworn on oath, says: That I have knowledge of the facts, statements, and matters herein contained and the log of the above-described well as filed and that the same are true and correct. So help me God.

(Signature) R. E. Mallonee
820 Union Center, Wichita, Kansas
(Address)

SUBSCRIBED AND SWORN TO before me this 30th day of March, 19 59

My commission expires December 14, 1961
Myranda Long Notary Public.

PLUGGING
FILE SEC. 18 T 25 R 13W
BOOK PAGE 27 LINE 13

DRILLERS' LOG

#1 C.S. Curtis
SE-SW NE Section 18-25-13W
Stafford County, Kans.

OPERATOR: McKnab Production Company, Inc. COMMENCED: 3-13-59
CONTRACTOR: Mallonee Drilling Company, Inc. COMPLETED: 3-27-59

D & A

FROM	TO	DESCRIPTION	<u>CASING RECORD</u>	
0	40	Surface sand		
40	200	Sand		
200	370	Shale	8-5/8" surface casing set at 265' with 225 sacks common cement, 2 CC.	
370	830	Shale, red bed, sand		
830	855	Anhydrite		
855	1055	Shale, sand and shells		
1055	1420	Shale and shells	Elevation:	1961 R.B.
1420	1800	Shale and lime shells	Heebner	3518 -1557
1800	3050	Lime and shale	Brown Lime	3664 -1703
3050	3140	Shale and shells	Lansing	3694 -1733
3140	3250	Shale and lime shells	BKC	3953 -1992
3250	3340	Lime and shale	Mississippi	4060 -2099
3340	3425	Lime	Kinderhook	4100 -2139
3425	4100	Lime and shale	Viola	4162 -2201
4100	4114	Chert and lime	Simpson	4242 -2281
4114	4180	Lime, shale, chert	Arbuckle	4297 -2336
4180	4219	Chert	R.T.D.	4325 -2364
4219	4305	Lime and shale		
4305	4325	Lime		
4325		Rotary Total Depth		

DST #1, 3821 - 3837
Open 1 hour, recovered 70' oil and gas cut mud, 60' water. FBHP 1315#

DST #2, 4048 - 4075
Open 1 hour, recovered 40' mud. FBHP 68#

DST #3, 4082 - 4114
Open 1 hour, recovered 330' gas in pipe, 90' very slightly oil and gas cut mud. FBHP 205#


I hereby certify that the above is a true and accurate Drillers' Log of the captioned well, to the best of my knowledge and belief.


R. E. Mallonee

State of Kansas)
) ss
County of Sedgwick)

Subscribed and sworn to before me this 30th day of March, 1959.

My commission expires:
December 14, 1961

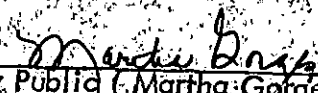
Notary Public (Martha Gorges)

<p>PLUGGING FILE SEC 18 T 25 R 13W BOOK PAGE 27 LINE 13</p>
--