

STATE OF KANSAS
STATE CORPORATION COMMISSION


WELL PLUGGING RECORD

Give All Information Completely
Make Required Affidavit
Mail or Deliver Report to:
Conservation Division
State Corporation Commission
212 No. Market
Wichita, Kansas

STAFFORD County, Sec. 18 Twp. 25S Rge. (E) 13 (W)

Location as "NE/CNW/SW" or footage from lines NE NW SE
Lease Owner SAM P. WALLINGFORD, INC.
Lease Name CURTIS Well No. 1
Office Address 304 COLO-DERBY BUILDING - WICHITA, KANSAS
Character of Well (completed as Oil, Gas or Dry Hole) OIL
Date well completed 19
Application for plugging filed NOVEMBER 11 19 68
Application for plugging approved 19
Plugging commenced DECEMBER 2 19 68
Plugging completed DECEMBER 5 19 68
Reason for abandonment of well or producing formation DEPLETED

NORTH

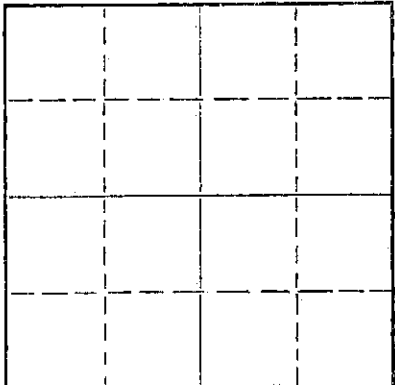

Locate well correctly on above Section Plat

If a producing well is abandoned, date of last production 19
Was permission obtained from the Conservation Division or its agents before plugging was commenced? YES

Name of Conservation Agent who supervised plugging of this well MR. WARREN
Producing formation Depth to top Bottom Total Depth of Well 4315' Feet
Show depth and thickness of all water, oil and gas formations.

OIL, GAS OR WATER RECORDS

CASING RECORD

FORMATION	CONTENT	FROM	TO	SIZE	PUT IN	PULLED OUT
				8 5/8"	264'	NONE
				4 1/2"	4290'	2147.95'

Describe in detail the manner in which the well was plugged, indicating where the mud fluid was placed and the method or methods used in introducing it into the hole. If cement or other plugs were used, state the character of same and depth placed, from feet to feet for each plug set.

- 4315' - 3866' - PLUG
- 3866' - 3810' - SAND
- 3810' - 3774' - 3 SACKS CEMENT
- 3774' - 556' - MUD
- 556' - 255' - 75 SACKS CEMENT
- 255' - 30' - MUD
- 30' - BASE - 10 SACKS CEMENT

RECEIVED
STATE CORPORATION COMMISSION
DEC 17 1968
CONSERVATION DIVISION
Wichita, Kansas

(If additional description is necessary, use BACK of this sheet)
Name of Plugging Contractor SANTA-FE PIPE & SUPPLY, INC.
Address BOX 562 - GREAT BEND, KANSAS

STATE OF KANSAS COUNTY OF BARTON, ss.
T. L. NUTT (employee of owner) or (owner or operator) of the above-described

well, being first duly sworn on oath, says: That I have knowledge of the facts, statements, and matters herein contained and the log of the above-described well as filed and that the same are true and correct. So help me God.

(Signature) [Signature]
BOX 562 - GREAT BEND, KANSAS
(Address)

SUBSCRIBED AND SWORN to before me this 16th day of DECEMBER, 19 68

My commission expires July 31, 1970

[Signature]
Mary M. Guesnier
Notary Public.

WELL LOG BUREAU—KANSAS GEOLOGICAL SOCIETY

508 East Murdock,

Wichita, Kansas


COPY

Company- McKNAB PRODUCTION CO.
Farm- Curtis No. 1

SEC. 18 T. 25 R. 13W
NE NW SE

Total Depth. 4315'
Comm. 4-1-59 Comp. 4-10-59
Shot or Treated.
Contractor. Mallonee Drlg.
Issued. 6-3-61

County Stafford
KANSAS

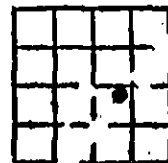

CASING:
8" 264'
4" 4290'

Elevation. 1962' RB

Production. 15 DOPD

Figures indicate Bottom of Formations.

COMPLETE DRILLERS LOG NOT AVAILABLE:

TOPS: S COUT	
Heebner	3504
Brown Lima	3654
Lansing	3678
Base Kansas City	3942
Viola	4089
Arbuckle	4291
Total Depth	4315

RECEIVED
STATE CORPORATION COMMISSION
NOV 19 1968
CONSERVATION DIVISION
Wichita, Kansas

RECEIVED
NOV 2 - 1968
Santa Fe Pipe & Supply