

STATE OF KANSAS
STATE CORPORATION COMMISSION


Form CP-4

WELL PLUGGING RECORD

Give All Information Completely
Make Required Affidavit
Mail or Deliver Report to:
Conservation Division
State Corporation Commission
212 No. Market
Wichita, Kansas

Stafford County, Sec. 18 Twp. 25s Rge. 13 (#) (W)

Location as "NE/CNW/SW" or footage from lines NE SE NE
Lease Owner Petroleum, Inc.
Lease Name Curtis 'H' Well No. 1
Office Address R.R. #2, Great Bend, Kansas
Character of Well (completed as Oil, Gas or Dry Hole) Dry hole
Date well completed November 18, 1967
Application for plugging filed November 18, 1967
Application for plugging approved November 18, 1967
Plugging commenced November 18, 1967
Plugging completed November 18, 1967
Reason for abandonment of well or producing formation no producible zone

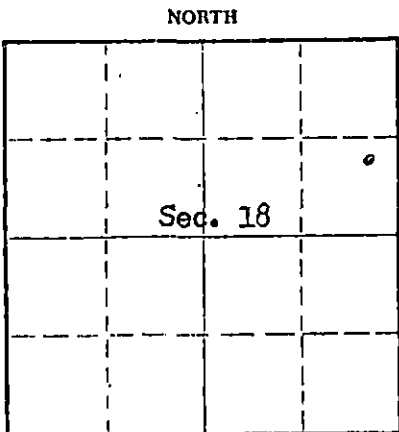

Locate well correctly on above Section Plat

If a producing well is abandoned, date of last production none 19
Was permission obtained from the Conservation Division or its agents before plugging was commenced? yes

Name of Conservation Agent who supervised plugging of this well Archie Elving
Producing formation _____ Depth to top _____ Bottom _____ Total Depth of Well 3695 Feet
Show depth and thickness of all water, oil and gas formations.

OIL, GAS OR WATER RECORDS

CASING RECORD

FORMATION	CONTENT	FROM	TO	SIZE	PUT IN	PULLED OUT
				8-5/8"	282'	none

Describe in detail the manner in which the well was plugged, indicating where the mud fluid was placed and the method or methods used in introducing it into the hole. If cement or other plugs were used, state the character of same and depth placed, from _____ feet to _____ feet for each plug set.

Mud to 280', 1/2 sack hulls followed by wooden plug; placed 20 sacks cement on top of plug. Mud to 40', 1/2 sack hulls followed by wooden plug, placed 8 sacks cement on top of plug to base of well cellar.

RECEIVED
STATE CORPORATION COMMISSION
NOV 30 1967

RECEIVED
STATE CORPORATION COMMISSION
NOV 27 1967

CONSERVATION DIVISION
WICHITA, KANSAS

CONSERVATION DIVISION
WICHITA, KANSAS

11-30-67

(If additional description is necessary, use BACK of this sheet)

Name of Plugging Contractor Garvey Drilling Company
Address Route 2, Great Bend, Kansas

STATE OF Kansas, COUNTY OF Barton, ss.
Monte Chadd (employee of owner) or (~~owner~~) of the above-described well, being first duly sworn on oath, says: That I have knowledge of the facts, statements, and matters herein contained and the log of the above-described well as filed and that the same are true and correct. So help me God. Monte Chadd, Dist. Prod. Supt.

(Signature) [Signature]
Route 2, Great Bend, Kansas 67530
(Address)

SUBSCRIBED AND SWORN to before me this 22 day of November, 19 67

My commission expires May 28, 1969 Richard H. Dumbler Notary Public.

WELL LOG

COMPANY Petroleum, Inc.

BEG. 18 T. 25S R. 13W

FARM Curtis

NO. H-1

LOC. NE SE NE


TOTAL DEPTH 3695'

COUNTY Stafford

COMM. 11-12-67

COMP. 11-18-67

CONTRACTOR Garvey Drilling Company

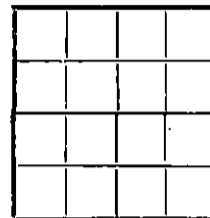

CASING 8 5/8" @ 282' w/250 SX

ELEVATION 1959' KB

PRODUCTION D & A

FIGURES INDICATE BOTTOM OF FORMATIONS

200' Sand
282' Red Bed
832' Red Bed and Shale
853' Anhydrite
1460' Shale and Shells
1868' Shale and Lime Streaks
2015' Shale and Lime
2240' Lime with Shale
3245' Shale and Lime
3695' Lime and Shale
3695' RTD

RECEIVED
STATE CORPORATION COMMISSION
NOV 27 1967
CONSERVATION DIVISION
Wichita, Kansas

State of Kansas

County of Barton

I, Sam N. Stephens of Garvey Drilling Company

upon oath state the above and foregoing is a true and correct copy of the log of the Curtis H-1 well.

Subscribed and sworn to before me this 22nd day of November 1967

My Commission Expires: May 28, 1969

Sam N. Stephens
Richard W. Dumbler
NOTARY PUBLIC