

STATE OF KANSAS  
STATE CORPORATION COMMISSION

WELL PLUGGING RECORD

Give All Information Completely  
Make Required Affidavit  
Mail or Deliver Report to  
Conservation Division  
State Corporation Comm.  
245 North Water  
Wichita, KS 67202

Stafford County, Sec. 29 Twp. 25 Rge. 13 E/W  
Location as "NE/CNW/SW" or footage from lines  
S/2 NE SW


Lease Owner Icer Addis  
Lease Name McCandless Well No. 1  
Office Address Drawer 8038 - Wichita, Ks. 67208  
Character of Well (Completed as Oil, Gas or Dry Hole) Dry Hole

Date Well completed October 1 1978  
Application for plugging filed Oct. 1 1978  
Application for plugging approved Oct 1 1978  
Plugging commenced Oct 1 1978  
Plugging completed Oct 1 1978  
Reason for abandonment of well or producing formation

If a producing well is abandoned, date of last production 19

Was permission obtained from the Conservation Division or its agents before plugging was commenced? yes

Name of Conservation Agent who supervised plugging of this well William Owen  
Producing formation Depth to top Bottom Total Depth of Well 4305  
Show depth and thickness of all water, oil and gas formations.

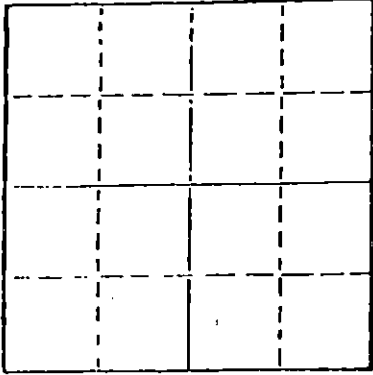

Locate well correctly on above Section Plat

OIL, GAS OR WATER RECORDS

CASING RECORD

FORMATION	CONTENT	FROM	TO	SIZE	PUT IN	PULLED OUT

Describe in detail the manner in which the well was plugged, indicating where the mud fluid was placed and the method or methods used in introducing it into the hold. If cement or other plugs were used, state the character of same and depth placed, from feet to feet for each plug set.

Bottom plug @ 540' w/40 sacks 50/50 pozmix thru drill pipe  
Middle plug @ 240' w/40 sks. " " " " "  
Top plug @ 40' w/1/2 sacks hulls, 12 sacks cement  
3 sacks cement in rat hole.

RECEIVED  
STATE CORPORATION COMMISSION  
OCT - 5 1978

CONSERVATION DIVISION  
Wichita, Kansas

(If additional description is necessary, use BACK of this sheet)

Name of Plugging Contractor Duke Drilling Co., Inc.

STATE OF Kansas COUNTY OF Barton, ss.

Bill Draney (employee of owner) or (owner or operator) of the above-described well, being first duly sworn on oath, says: That I have knowledge of the facts, statements, and matters herein contained and the log of the above-described well as filed and that the same are true and correct. So help me God.

(Signature) Bill Draney  
Box 823 - Great Bend, Ks. 67530  
(Address)

SUBSCRIBED AND SWORN TO before me this 3 day of October, 1978

Notary Public. (Signature)

My commission expires 4-11-1982

DRILLERS' WELL LOG

DATE COMMENCED: September 23, 1978  
 DATE COMPLETED: October 1, 1978

Locer Addr:  
 McCANDLESS #1  
 S/2 NE SW  
 Sec. 29--T25N-R13W  
 Stafford County, Ks.

ELEVATION: 1959 K.B.

0 - 214' Sand & Shale Streaks  
 214 - 248' Shale & Red Bed  
 248 - 265' Anhydrite  
 265 - 1600' Shale & Lime Streaks  
 1600 - 2165' Lime & Shale  
 2165 - 3556' Shale & Lime  
 3556 - 3560' Shale  
 3560 - 3571' Lime & Shale  
 3571 - 3594' Lime  
 3594 - 3717' Shale  
 3717 - 3744' Lime & Shale  
 3744 - 3984' Lime  
 3984 - 4087' Lime & Shale  
 4087 - 4137' Chert & Lime  
 4137 - 4298' Chert  
 4298 - 4305' Sand - Shale  
 4305' RTD

FORMATION DATA

ANHYDRITE	248
HEESNER	3556
TORONTO	3571
DOUGLAS	3594
BR. LIME	3717
LANSING - KG	3744
BASE K.C.	3984
MISSISSIPPI	4087
VIOLA	4137
STAPSON SAND	4298
RTD	4305

RECEIVED  
 STATE CORPORATION COMMISSION

OCT - 5 1978

CONSERVATION DIVISION  
 Wichita, Kansas

SURFACE PIPE: Set used 8-5/8",  
 237 @ 231' with 165 sacks 60/40  
 porous, 2 1/2 Col, 3cc.

AFFIDAVIT

STATE OF KANSAS  
 COUNTY OF BARTON ) ss

Bill Draney, of lawful age does swear and state that the facts and  
 statements herein contained are true and correct to the best of his knowledge.

*Bill Draney*

Subscribed and sworn to before me this 3rd day of October 1978

*Dorothy M. Hague*  
 Notary Public

By Commission expires: April 11 1982