


STATE OF KANSAS
STATE CORPORATION COMMISSION

Give All Information Completely
Make Required Affidavit
Mail or Deliver Report to:
Conservation Division
State Corporation Commission
800 Bittling Building
Wichita, Kansas

WELL PLUGGING RECORD

NORTH

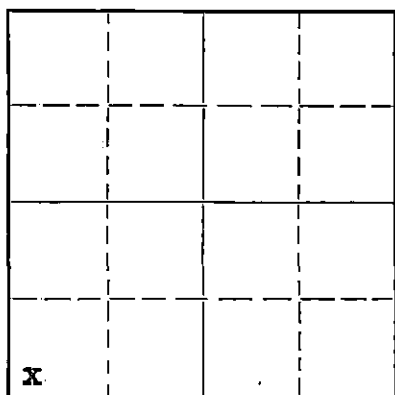

Locate well correctly on above
Section Plat

Stafford

County. Sec. 29 Twp. 25S Rge. 13 (W)

Location as "NE/CNW $\frac{1}{4}$ SW $\frac{1}{4}$ " or footage from lines 330' from So. & 330' from W Sec.

Lease Owner Sun Oil Company

Lease Name McCandless

Well No. 1

Office Address Box 1348, Tulsa, Oklahoma.

Character of Well (completed as Oil, Gas or Dry Hole) Dry Hole

Date well completed July 19 1949

Application for plugging filed August 1 1950

Application for plugging approved August 3 1950

Plugging commenced August 4 1950

Plugging completed August 14 1950

Reason for abandonment of well or producing formation Dry Hole

If a producing well is abandoned, date of last production X 19

Was permission obtained from the Conservation Division or its agents before plugging was commenced? Yes

Name of Conservation Agent who supervised plugging of this well C.D. Stough, Great Bend, Kansas

Producing formation None Depth to top Bottom PB Total Depth of Well 3888 Feet

Show depth and thickness of all water, oil and gas formations.

OIL, GAS OR WATER RECORDS

CASING RECORD

Formation	Content	From	To	Size	Put In	Pulled Out
Lansing	S. Wtr. (sho. 811)	3720	3976	10-3/4"	833'	None
Simpson	Dry	4278	4300			
Arbuckle	-	4322	4336	5 1/2"	4001'	2748

Describe in detail the manner in which the well was plugged, indicating where the mud fluid was placed and the method or methods used in introducing it into the hole. If cement or other plugs were used, state the character of same and depth placed, from.....feet to.....feet for each plug set.

10-3/4" OD 32.75# SS Casing set at 833'. Cemented 1000 sacks. Squeezed 700 sks

5 1/2" OD 14# J55 SS Casing set at 4001' cemented 200 sacks.

PBSD 3888' perfs. open 3862'-3878'.

8-6-50: Bailed heavy fluid and P.B. with crushed rock 3888' to 3842' spotted 5 sacks cement 3842'-3812'. Shot pipe off at 2748' pulled 5 1/2" casing, filled hole with heavy mud from 3812' to approximately 800'. Squeezed with 400 sacks cement by Halliburton from approximately 800' to bottom of cellar.

8-14-50: Finished plugging, Pipe Pulling Inc., 629 W. Broadway, Stafford, Kansas.

(If additional description is necessary, use BACK of this sheet)

Correspondence regarding this well should be addressed to Sun Oil Company, P. O. Box 1348,
Address Tulsa, Oklahoma.

STATE OF Oklahoma, COUNTY OF Tulsa, ss.

.....(employee of owner) or (owner or operator) of the above-described well,
being first duly sworn on oath, says: That I have knowledge of the facts, statements, and matters herein contained and the log of the above-described well as filed and that the same are true and correct. So help me God.

(Signature)

Glen D. Hughes, Production Supt.
Box 1348, Tulsa, Oklahoma.

(Address)

SUBSCRIBED AND SWORN to before me this 6th day of Sept., 1950

Notary Public.

My commission expires 5-9-51

28-8273-s.

4-50-10M

PLUGGING

FILE SEC 29 T25 R13W

BOOK PAGE 19 LINE 9

DRILLERS LOG

McCANDLESS NO. 1
C/SW4 SW4 SW4
Sec. 29, Twp. 25S, Rge. 13W
Stafford County, Kansas

10-3/4" 32.75# Casing seat 833' w/1000 sacks
5 1/2" OD 14# casing seat 4001' w/200 sacks

Surface Clay & Sand	0	75	Shale & Shells	2600	2700
Sand	75	200	Shale & Shells	2700	2800
Red Beds	200	475	Shale & Shells	2800	2895
Red Beds	475	500	Shale & Shells	2895	2975
Sand	500	570	Lime	2975	3020
Red Beds & Shale	570	815	Shale & Shells	3020	3040
Shale & Shells	815	829	Lime	3040	3055
Anhydrite	829	834	Lime	3055	3100
Lime	834	850	Shale	3100	3155
Red Rock	850	865	Shale & Shells	3155	3245
Lime	865	890	Lime	3245	3320
Red Rock	890	980	Lime	3320	3410
Shale & Shells	980	1350	Lime & Shale Broken	3410	3480
Shale, Salt & Shells	1350	1560	Broken Lime	3480	3545
Shale & Salt	1560	1610	Lime	3545	3590
Shale	1610	1670	Shale	3590	3660
Shale & Shells	1670	1725	Shale	3660	3705
Lime	1725	1745	Broken Lime	3705	3735
Shale	1745	1770	Lime	3735	3775
Lime	1770	1800	Lime	3775	3800
Lime	1800	1845	Lime	3800	3825
Broken Lime	1845	1865	Lime	3825	3860
Lime	1865	1905	Lime	3860	3879
Lime	1905	1975	Lime	3879	3881
Broken Lime	1975	2040	Lime	3881	3905
Lime	2040	2075	Lime	3905	3955
Plug & Cement (Squeezed)			Lime	3955	3980
Hole w/700 sacks)	820	900	Lime	3980	3995
Red Rock & Shale	900	1040	Broken Lime	3995	4065
Shale & Shells	1040	1265	Broken Lime	4065	4115
Shale & Shells	1265	1350	Lime & Chert	4115	4148
Shale, Salt & Shells	1350	1535	Lime & Chert	4148	4163
Shale & Shells	1535	1700	Shale & Chert Shells	4163	4185
Shale & Shells	1700	1725	Shale & Lime	4185	4204
Lime	1725	1745	Lime, Chert & Shale	4204	4235
Shale	1745	1770	Chert	4235	4242
Lime	1770	1870	Chert	4242	4255
Broken Lime	1870	1985	Lime & Chert	4255	4268
Lime	1985	2115	Lime & Sand	4268	4290
Shale & Shells	2115	2230	Lime & Sand	4290	4295
Lime	2230	2275	Sand (Cored)	4295	4305
Broken Lime	2275	2310	Hard Sand & Shale (Cored)	4305	4310
Lime	2310	2418	Lime	4310	4330
Shale	2418	2430	Lime	4330	4336
Broken Lime	2430	2510			
Broken Lime	2510	2575			
Lime	2575	2600	Total Depth		4336

I hereby certify that the foregoing is a true and correct copy of the McCandleless No. 1 Well Driller's Log as it is recorded on the books of the Sun Oil Company.

Glen D. Hughes
Glen D. Hughes

STATE OF OKLAHOMA)
COUNTY OF TULSA) SS

Subscribed and sworn to before me this 8th day of September 1950

Blanche T. H.
Notary Public

My Commission Expires:

5-9-51

PLUGGING
FILE SEC 29 T25 R13
BOOK PAGE 19 LINE 9