


STATE OF KANSAS
STATE CORPORATION COMMISSION

WELL PLUGGING RECORD

Give All Information Completely
Make Required Affidavit
Mail or Deliver Report to:
Conservation Division
State Corporation Commission
800 Biting Building
Wichita, Kansas

Stafford County, Sec. 30 Twp 25S Rge. (E) 13 (W)
Location as "NE/CNW 1/4 SW 1/4" or footage from lines SE SE NE
Lease Owner Beardmore Drilling Company
Lease Name McCandless B Well No. 1
Office Address 603 Petroleum Bldg., Wichita, Kansas
Character of Well (completed as Oil, Gas or Dry Hole) dry hole
Date well completed December 20 1951
Application for plugging filed December 20 1951
Application for plugging approved December 20 1951
Plugging commenced December 20 1951
Plugging completed December 20 1951
Reason for abandonment of well or producing formation dry hole
If a producing well is abandoned, date of last production 19
Was permission obtained from the Conservation Division or its agents before plugging was commenced?

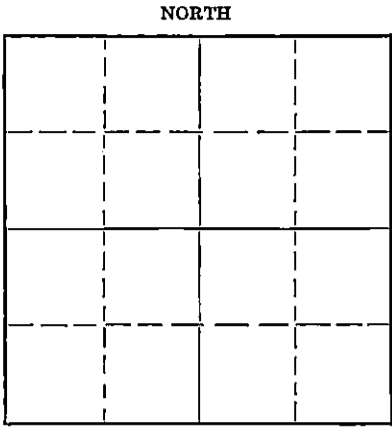

Locate well correctly on above Section Plat

Name of Conservation Agent who supervised plugging of this well C. D. Stough, Box 207, Great Bend, Kansas
Producing formation Depth to top Bottom Total Depth of Well 4399 Feet
Show depth and thickness of all water, oil and gas formations.

OIL, GAS OR WATER RECORDS

CASING RECORD

Formation	Content	From	To	Size	Put In	Pulled Out
		-	1110	8-5/8	1110	None

Describe in detail the manner in which the well was plugged, indicating where the mud fluid was placed and the method or methods used in introducing it into the hole. If cement or other plugs were used, state the character of same and depth placed, from top bottom feet for each plug set.

Mud from 4399 to 1110, plug at 1110, 15 sacks cement; mud to 30', Plug at 30', 10 sacks cement to complete.

(If additional description is necessary, use BACK of this sheet)

Name of Plugging Contractor Beardmore Drilling Company
Address 603 Petroleum Bldg., Wichita 2, Kansas

STATE OF KANSAS, COUNTY OF SEDGWICK, ss.
I, Heber Beardmore, (employee of owner) or (owner or operator) of the above-described well, being first duly sworn on oath, says: That I have knowledge of the facts, statements, and matters herein contained and the log of the above-described well as filed and that the same are true and correct. So help me God.

(Signature) Heber Beardmore
603 Petroleum Bldg., Wichita 2, Kansas (Address)

SUBSCRIBED AND SWORN to before me this 31st day of December, 1951

My commission expires January 19, 1955

23-8390-s 6-51-20M

RECEIVED Notary Public
STATE CORPORATION COMMISSION
JAN - 2 1952

My commission expires: Nov. 1, 1953

PLUGGING
FILE SEC 30 T 25 R 13e
BOOK PAGE 133 line 18

McCandless B#1

SE SE NE
Section 30-25S-13W
Stafford County, Kansas

Drilled for: Beardmore and Lebow
Drilled By: Beardmore Drilling Company

Casing Record:

8-5/8" 1140' w/500 Sacks

Drilling Commenced: December 6, 1951
Drilling Completed: December 20, 1951

Elevation: 1953 DF
1951 GR

<u>FORMATION</u>	<u>DEPTH</u>
Sand Soil	30
Sand	300
Red Bed and Shale	510
Shale - Shells	700
Lime - Shale	875
Shale - Shells	1770
Lime Broken	1920
Shale - Lime	2120
Broken Lime	2515
Shale - Lime	3280
Lime - Shale	3400
Lime Broken	3770
Lime	4180
Lime - Chert	4215
Lime	4255
Lime Broken	4285
Lime	4399 T. D.

D & A

TOPS:

Lansing	3721
Conglomerate	4082
Mississippi	4127
Viola	4212
Simpson	4319
Arbuckle	4380

DST #1 - 3868-3880 - Open 1 hour, Recovered 30' mud. Zero # BHP

DST #2 - 4319-4368 - Open 45 minutes, Recovered 200' Mud, 200' Water,
750# BHP.

STATE OF KANSAS

ss

COUNTY OF SEDGWICK

I, the undersigned, Being duly sworn on oath state that the above and within statement is a true and correct record and log of the well drilled on the location above-described, to the best of my knowledge and belief.



Subscribed and sworn to before me this 31st day of December, 1951.


Notary Public

My Commission Expires: January 19, 1955

My commission expires: Nov. 1, 1953

RECEIVED
STATE CORPORATION DIVISION
JAN - 2 1952
CONSERVATION DIVISION
Topeka, Kansas

PLUGGING

FILE SEC 30 25 R 13W
BOOK PAGE 133 11