

STATE OF KANSAS
STATE CORPORATION COMMISSION

Give All Information Completely
Make Required Affidavit
Mail or Deliver Report to:
Conservation Division
State Corporation Commission
800 Bitting Building
Wichita, Kansas

WELL PLUGGING RECORD

NORTH

**Locate well correctly on above
Section Plat**

Stafford County. Sec. 30. Twp. 25. Rge. (E) 13 (W)
 Location as "NE/CNW¼SW¼" or footage from lines Cen. SW SE SW
 Lease Owner Cities Service Oil Company
 Lease Name Goodman Well No. 3
 Office Address Bartlesville, Oklahoma
 Character of Well (completed as Oil, Gas or Dry Hole) Dry Hole
 Date well completed November 3, 1949
 Application for plugging filed November 3, 1949
 Application for plugging approved November 4, 1949
 Plugging commenced November 4, 1949
 Plugging completed November 4, 1949
 Reason for abandonment of well or producing formation Dry Hole

If a producing well is abandoned, date of last production.....19.....
Was permission obtained from the Conservation Division or its agents before plugging was com-
menced? Yes

Name of Conservation Agent who supervised plugging of this well..... C. D. Stough

Producing formation..... Simpson..... Depth to top..... 4279..... Bottom..... 4306..... Total Depth of Well..... 4306..... Feet

Show depth and thickness of all water, oil and gas formations.

OIL, GAS OR WATER RECORDS

CASING RECORD

[illegible]

Describe in detail the manner in which the well was plugged, indicating where the mud fluid was placed and the method or methods used in introducing it into the hole. If cement or other plugs were used, state the character of same and depth placed, from.....feet tofeet for each plug set.

4306' to 250' heavy mud
250' to 200' wood plug and 15 sacks cement
200' to 35' mud and soil
35' to base of cellar. 10 sacks cement

RECEIVED

NOV 22 1949

STATE COMMISSION
KANSAS

(If additional description is necessary, use BACK of this sheet)


Correspondence regarding this well should be addressed to..... R. C. Cooper
Address..... Box 751
..... Great Bend, Kansas

STATE OF Kansas, COUNTY OF Barton, ss.
V. M. Conover (employee of owner) or ~~(owner or operator)~~ of the above-described well,
being first duly sworn on oath, says: That I have knowledge of the facts, statements, and matters herein contained and the log of the above-described well as filed and that the same are true and correct. So help me God.

(Signature) Wm. Coward
Box 751, Great Bend, Kansas
(Address)

SUBSCRIBED AND SWORN to before me this 16th day of November, 1949.

My commission expires March 12, 1957. Notary Public.

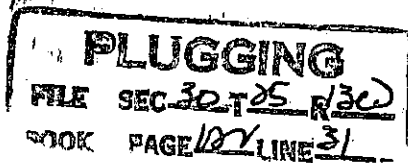

WELL RECORD

Company Cities Service Oil Co. Well No. 3 Farm Goodman
 Location 330' North and 990' West of S/4 Cor. Sec. 30 T. 25 R. 13W
 Elevation 1971 (1969 Gr.) County Stafford State Kansas
 Drlg. Comm. October 19, 1949 Contractor R. W. Rine Drilling Company
 Drlg. Comp. November 3, 1949 Acid None
 T. D. 4306' Initial Prod. None - Plugged and Abandoned 11-4-49

CASING RECORD:

8-5/8" @ 859' cem. 500 ex cement,
 250# Floco and
 500# C. C.

FORMATION RECORD:

sand & shale	0-310
red bed	840
anhydrite	863
sand, shale, shells	1230
shale & salt	1750
lime & shale	2090
shale & lime	2245
lime & shale	2375
shale	2655
shale & lime	3170
lime & shale	3305
shale	3385
shale & lime	3520
lime & shale	3735
lime	3908
lime & shale	4233
cherty lime	4248
chert	4259
lime & chert	4265
cherty lime & shale	4286
cored sand, rec. 4'-4"	4291
cored sand, rec. 4'-8"	4296
cored sand & shale, rec. 8'-2"	4306 T. D.

Top Lansing	3724'
Top Mississippi	4107'
Top Kinderhook	4193'
Top Viola	4221'
Top Simpson Shale	4273'
Top Simpson Sand	4279'
Total Depth	4306'

D. S. T. 4258-65, rec. 540' salt
 water and rotary mud in 30 mins.

D. S. T. 4280-91, rec. 11' oil-
 cut mud with show free oil in 30
 mins.

D. S. T. 4280-96, rec. 11' slightly
 oil-cut mud with trace free oil in
 30 mins.

SYFO:	500'	0°
	1000'	1°
	1500'	1°
	2000'	1°
	2500'	0°
	3000'	2°
	3500'	1°

RECEIVED

NOV 22 1949

PLUGGING

FW SEC 30 T 25 R 13W

BOOK PAGE 22 31