


STATE OF KANSAS  
STATE CORPORATION COMMISSION  
Give All Information Completely  
Make Required Affidavit  
Mail or Deliver Report to:  
Conservation Division  
State Corporation Commission  
212 No. Market  
Wichita, Kansas

WELL PLUGGING RECORD

Stafford County. Sec. 26 Twp. 25 Rge. 13 (E) (W) x  
Location as "NE/CNW/SW" or footage from lines NE SW SE  
Lease Owner Koch Exploration Inc.  
Lease Name Fischer Well No. #1  
Office Address 321 W. Douglas, Wichita, Kansas  
Character of Well (completed as Oil, Gas or Dry Hole)  
Date well completed 19  
Application for plugging filed 19  
Application for plugging approved 19  
Plugging commenced 7-30-68 19  
Plugging completed 8-3-68 19  
Reason for abandonment of well or producing formation  
If a producing well is abandoned, date of last production 19  
Was permission obtained from the Conservation Division or its agents before plugging was commenced?

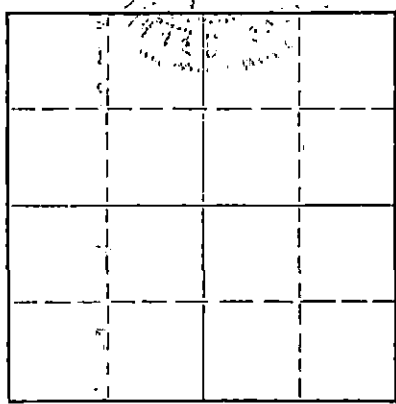

Locate well correctly on above Section Plat

Name of Conservation Agent who supervised plugging of this well Ralph J. Warren  
Producing formation Depth to top Bottom Total Depth of Well 4294' Feet  
Show depth and thickness of all water, oil and gas formations.

OIL, GAS OR WATER RECORDS CASING RECORD

FORMATION	CONTENT	FROM	TO	SIZE	PUT IN	PULLED OUT
				5 1/2"	4294'	2945.80'
				8 5/8"	350'	

Describe in detail the manner in which the well was plugged, indicating where the mud fluid was placed and the method or methods used in introducing it into the hole. If cement or other plugs were used, state the character of same and depth placed, from feet to feet for each plug set.

Pushed plug to 4100; wash 40' sand, Mixed and dumped 5 sacks cement through dump bailer  
Squeezed hole with 5 sacks gel from 640' to 415'. 50 sacks cement from 415' to 265';  
5 sacks gel from 265' to 40', 10 sacks cement from 40' to base of cellar.

RECEIVED  
STATE CORPORATION COMMISSION  
AUG 6 1968  
CONSERVATION DIVISION  
Wichita, Kansas

(If additional description is necessary, use BACK of this sheet)

Name of Plugging Contractor Southwest Casing Pulling Co., Inc.  
Address Box 364, Great Bend, Kansas 67530

STATE OF Kansas, COUNTY OF Barton, ss.  
Southwest Casing Pulling Co., Inc. (employee of owner) or (owner or operator) of the above-described well, being first duly sworn on oath, says: That I have knowledge of the facts, statements, and matters herein contained and the log of the above-described well as filed and that the same are true and correct. So help me God.

(Signature) W. C. Spencer Sec.  
Box 364, Great Bend, Kansas  
(Address)

SUBSCRIBED AND SWORN to before me this 5th day of August, 1968

My commission expires October 1968  
D. MILLER  
NOTARY PUBLIC  
BARTON COUNTY, KANSAS

Sidney D. Miller  
Notary Public.

DRILLER'S LOG

COMPANY: Rock Island Oil & Refining Co., Inc.  
 CONTRACTOR: LEBEN DRILLING, INC.  
 FARM: FISCHER #1  
 LOCATION: NE SW SE Sec. 26-25S-13W  
 STAFFORD COUNTY, KANSAS  
 COMMENCED: 7-18-63  
 COMPLETED: 7-29-63

0	155	Sand & Clay
155	225	Sand
225	305	Redbed
305	335	Sand
335	357	Shale
357	769	Redbed
769	800	Anhydrite
800	1300	Shale & Shells
1300	1730	Shale & Lime
1730	2325	Lime
2325	2650	Lime & Shale
2650	2750	Shale & Lime
2750	3075	Lime & Shale
3075	4005	Lime
4005	4028	Conglomerate
4028	4094	Lime & Chert
4094	4110	Chat
4110	4135	Lime & Chert
4135	4138	Viola Chert
4138	4200	Lime & Chert
4200	4225	Sand
4225	4255	Simpson Shale
4255	4292	Shale
4292	4296	Lime
	<u>4296</u>	<u>Rotary Total Depth - Set 5 1/2" casing</u>

RECEIVED  
 STATE CORPORATION COMMISSION  
 JUL 17 1968  
 CONSERVATION DIVISION  
 Wichita, Kansas

Set 8 5/8" used surface casing @ 354' Cemented with 325 sacks Common with 3% c.c.

I, Leslie Kite, do hereby certify that the above and foregoing is a true and correct copy of the log of the Fischer #1, located NE SW SE of Section 26, Township 25South, Range 13 West, Stafford County, Kansas, as reflected by the files of Leben Drilling, Inc.

Leslie Kite  
 Leslie Kite.

STATE OF KANSAS )  
 ) SS  
 COUNTY OF BARTON)

Subscribed and sworn to before me, a Notary Public, in and for Barton County, Kansas, this 31st day of July, 1963.

Ulanda Nichols  
 Ulanda Nichols, Notary Public

My Commission Expires:  
 April 1, 1967