

STATE OF KANSAS
STATE CORPORATION COMMISSION

WELL PLUGGING RECORD

OR
FORMATION PLUGGING RECORD

Strike out upper line
when reporting plug-
ging off formations.

Give All Information Completely
Make Required Affidavit
Mail or Deliver Report to:
Conservation Division
State Corporation Commission
800 Bitting Building
Wichita, Kansas

Reno County, Sec. 18 Twp. 255 Rge. (E) 4 (W)
Location as "NE $\frac{1}{4}$ NW $\frac{1}{4}$ SW $\frac{1}{4}$ " or footage from lines SE SE SE

NORTH

Locate well correctly on above
Section Plat

Lease Owner Adair & Morton
 Lease Name Koch #1 Well No. _____
 Office Address Wheeler-Kelly-Hagney Bldg., Wichita, Kansas.
 Character of Well (completed as Oil, Gas or Dry Hole) _____
 Date well completed July 14, 1944
 Application for plugging filed July 14, 1944
 Application for plugging approved July 14, 1944
 Plugging commenced July 14, 1944
 Plugging completed July 14, 1944
 Reason for abandonment of well or producing formation _____

If a producing well is abandoned, date of last production _____ 19____
 Was permission obtained from the Conservation Division or its agents before plugging was com-
 menced? Yes

Name of Conservation Agent who supervised plugging of this well Reed Durkee, McPherson, Kansas
 Producing formation _____ Depth to top _____ Bottom _____ Total Depth of Well 4142 Feet
 Show depth and thickness of all water, oil and gas formations.

OIL, GAS OR WATER RECORDS


CASING RECORD

Formation	Content	From	To	Size	Put In	Pulled Out
				8 5/8	193	Cemented with 150 Sacks

Describe in detail the manner in which the well was plugged, indicating where the mud fluid was placed and the method or methods used in introducing it into the hold. If cement or other plugs were used, state the character of same and depth placed, from _____ feet to _____ feet for each plug set.

Filled with 106 Mud from 4142 to 195 feet. Put in Bridge from 195 feet up to 185 feet. Put 15 sacks cement on Bridge, filled with mud up to 20 feet. Put in Bridge and 5 sacks cement on Bridge. Cut off Surface pipe at base of collar and filled with soil to surface level.

PLUGGING
 FILE 18 25 4W
 BOOK 124 18-30

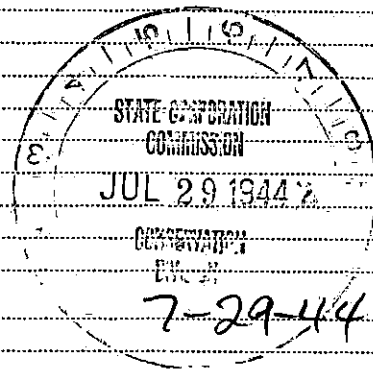

(If additional description is necessary, use BACK of this sheet)

Correspondence regarding this well should be addressed to Adair & Morton
 Address Wheeler-Kelly-Hagney Building, Wichita, Kansas

STATE OF Kansas, COUNTY OF Montgomery, ss.
Emmett C. Veeder, President (owner or operator) of the above-described well,

being first duly sworn on oath, says: That I have knowledge of the facts, statements, and matters herein contained and the log of the above-described well as filed and that the same are true and correct. So help me God.

THE VEEDER SUPPLY & DEVELOPMENT COMPANY
 (Signature) By: Emmett C. Veeder President
P. C. Box 270, Cherryvale, Kansas (Address)

Subscribed and sworn to before me this 18th day of July, 1944
Chas. Conrad Notary Public.



Jack Stewart
Nov. 4th 1914

Veeder Supply & Dev'l. Co.



Cherryvale, Kansas

Drilled for Adair-Morton Company Farm Koch No. 1 Depth 4142'
 Contractor The Veeder Supply & Development Co. Pipe 296' of 8-5/8" Surface Casing
 Location SE₂ SE Dry Sec 18 Twp. 25S Range 4W
 Commenced 6-18-44 Completed 7-14-44 County Reno State Kansas

FORMATION LOG

Soil	0	75	75	Shale	3880	3965	85
Shale, shell, redbed	75	197	122	Shale, sticky	3965	3985	20
Sand	197	227	30	Lime	3985	4010	25
Shale & shells	227	280	53	Lime & shale	4010	4032	22
Shale	280	375	95	Lime	4032	4068	36
Anhydrite	375	405	30	Lime, hard & cherty	4068	4070	2
Anhydrite & shale	405	875	470	Lime	4070	4076	6
Shale & shells	875	895	20	Conglomerate	4076	4090	14
Anhydrite	895	1083	188	Lime	4090	4142	52
Lime	1083	1163	80				
Hard sharp sand	1163	1185	22				
Lime & shale	1185	1300	115				
Lime, hard & cherty	1300	1335	35				
Shale & lime	1335	1370	35				
Shale & shells	1370	1490	120				
Shale & lime	1490	1595	105				
Shale & shells	1595	2010	415				
Shale	2010	2311	301				
Lime	2311	2725	414				
Lime-shale	2725	2785	60				
Shale-sticky	2785	2830	45				
Lime	2830	3210	380				
Shale & lime	3210	3270	60				
Lime	3270	3320	50				
Lime & shale	3320	3450	130				
Shale	3450	3385	-				
Shale & lime	3385	3424	39				
Shale	3424	3495	70				
Shale varigateo	3495	3518	23				
Chat	3518	3570	52				
Chat & shale	3570	3625	55				
Chat & chert	3625	3634	9				
Chert	3634	3695	61				
Chert & lime	3695	3720	25				
Chert	3720	3734	14				
Cherty lime	3734	3772	38				
Lime	3772	3780	8				
Lime & shale	3780	3880	100				

Miss 3518 KC ~~2770~~
 U 3984
 S 4010
 a 4090

AFFIDAVIT

FILE
 BOOK
 18 25 40
 124 38

STATE OF KANSAS)
COUNTY OF MONTGOMERY) SS:

EMMETT C. VEEDER, of lawful age, being duly and solemnly sworn on oath says:

I am a resident of Cherryvale, Montgomery County, Kansas and I hereby know and on oath state, that the above drilling log covering the Koch #1 well in Section 18-25S-4W, Reno County, Kansas, is true and correct.

Further affiant saith not.

THE VEEDER SUPPLY & DEVELOPMENT COMPANY,

By: Emmett C. Veeder
President.

Subscribed and sworn to before me this 18th day of July, 1944.

Colo Lourad
Notary Public

My Commission Expires: July 11, 1948

