


STATE OF KANSAS  
STATE CORPORATION COMMISSION

Form CP-4

Give All Information Completely  
Make Required Affidavit  
Mail or Deliver Report to:  
Conservation Division  
State Corporation Commission  
212 No. Market  
Wichita, Kansas

WELL PLUGGING RECORD

NORTH

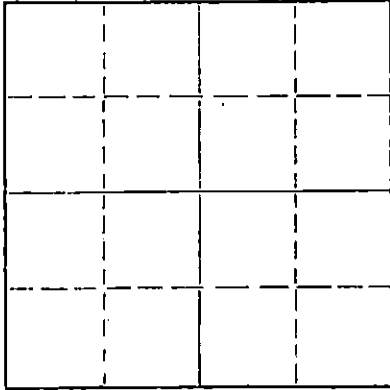

Locate well correctly on above  
Section Plat

Reno County, Sec. 18 Twp. 25S Rge. (X) 4 (W)  
Location as "NE/CNW/SW" or footage from lines 660 f/ S line & 1855 f/ E line  
Lease Owner Tesoro Petroleum Corporation  
Lease Name Hilda Weichman Well No. 1  
Office Address 533 Busby Drive, San Antonio, Texas 78209  
Character of Well (completed as Oil, Gas or Dry Hole) Dry Hole  
Date well completed November 17, 1967  
Application for plugging filed November 17, 1967  
Application for plugging approved November 17, 1967  
Plugging commenced November 17, 1967  
Plugging completed November 17, 1967  
Reason for abandonment of well or producing formation

If a producing well is abandoned, date of last production 19  
Was permission obtained from the Conservation Division or its agents before plugging was commenced? Yes

Name of Conservation Agent who supervised plugging of this well Herman Justus, Nickerson, Kansas  
Producing formation Depth to top Bottom Total Depth of Well 4002 Feet  
Show depth and thickness of all water, oil and gas formations.

OIL, GAS OR WATER RECORDS

CASING RECORD

FORMATION	CONTENT	FROM	TO	SIZE	PUT IN	PULLED OUT
				8-5/8"	248'	None

Describe in detail the manner in which the well was plugged, indicating where the mud fluid was placed and the method or methods used in introducing it into the hole. If cement or other plugs were used, state the character of same and depth placed, from feet to feet for each plug set.

Mudded up with heavy mud to 225 feet. Followed by wooden plug and 1/2 sack hulls. Placed 25 sacks cement onto hulls. Mudded up with heavy mud to 40 feet followed by wooden plug, 1/2 sack hulls and 10 sacks cement to base of well cellar. Plugged rat hole with 2 sacks cement.

RECEIVED  
STATE CORPORATION COMMISSION  
MAY 22 1967  
CONSERVATION DIVISION  
WICHITA, KANSAS

(If additional description is necessary, use BACK of this sheet)  
Name of Plugging Contractor Graves Drilling Co., Inc.  
Address 505 Union Center, Wichita, Kansas 67202

STATE OF KANSAS, COUNTY OF SEDGWICK, ss.  
John C. Graves (employee of owner) or (owner or operator) of the above-described well, being first duly sworn on oath, says: That I have knowledge of the facts, statements, and matters herein contained and the log of the above-described well as filed and that the same are true and correct. So help me God.

(Signature) John C. Graves  
505 Union Center, Wichita, Kansas 67202  
(Address)

SUBSCRIBED AND SWORN TO before me this 21st day of November, 1967

My commission expires May 9, 1971

Betty Brandt  
Betty Brandt Notary Public.

R O T A R Y D R I L L E R S ' L O G

OPERATOR: Tesoro Petroleum Corporation      DRILLING COMMENCED: November 6, 1967  
 533 Busby Drive  
 San Antonio, Texas

CONTRACTOR: Graves Drilling Co., Inc.      DRILLING COMPLETED: November 17, 1967  
 505 Union Center  
 Wichita, Kansas

CASING RECORD: 11 Jts. 248' 8-5/8"      LOCATION: Wilda Weichman No. 1  
 cemented with 240 sacks      660 from South Line and  
 1855 from East Line  
 Section 18-25S-4W  
 Reno County, Kansas

-----

0 - 50	Sod, clay & sand
50 - 656	Shale
656 - 990	Lime & shale streaks
990 - 1545	Lime & shale
1545 - 2166	Shale & lime
2166 - 2240	Lime & shale
2240 - 2535	Lime
2535 - 2539	Shale & lime
2539 - 2731	Shale & lime
2731 - 2766	Lime & shale
2766 - 3311	Lime
3311 - 3403	Lime & shale
3403 - 3485	Sandy shale & lime
3485 - 3513	Shale
3513 - 3580	Chert, cherty lime & chert
3580 - 3607	Chert
3607 - 3632	Lime
3632 - 3680	Lime & chert
3680 - 3791	Lime
3791 - 3969	Shale
3969 - 3987	Lime
3987 - 4002	Sand & Rotary Total Depth.

**RECEIVED**  
 STATE CORPORATION COMMISSION  
 NOV 22 1967  
 CONSERVATION DIVISION  
 Wichita, Kansas

I hereby certify the foregoing statements to be true and correct to the best of my knowledge.

GRAVES DRILLING CO., INC.

By *J. H. ...* President

STATE OF KANSAS    )  
                           )    SS:  
 SEDGWICK COUNTY    )

Subscribed and sworn to before me, a Notary Public, this 21st of November, 1967.

My commission expires: May 9, 1971.

*Betty Brandt*  
 Betty Brandt      Notary Public