

STATE OF KANSAS
STATE CORPORATION COMMISSION

WELL PLUGGING RECORD

Give All Information Completely
Make Required Affidavit
Mail or Deliver Report to:
Conservation Division
State Corporation Commission
800 Bitting Building
Wichita, Kansas

Reno County. Sec. 4 Twp. 25 Rge. 4 (E) (W)

Location as "NE/CNW $\frac{1}{4}$ SW $\frac{1}{4}$ " or footage from lines NE NE NW,

Lease Owner Kenwood Oil Company

Lease Name Kinast Well No. 1

Office Address 714 First National Bldg., Tulsa, Oklahoma

Character of Well (completed as Oil, Gas or Dry Hole) Dry Hole

Date well completed 12-28-19 54

Application for plugging filed 12-28-19 54


Application for plugging approved 12-28-19 54

Plugging commenced 12-28-19 54

Plugging completed 1-5-19 55

Reason for abandonment of well or producing formation Dry

NORTH

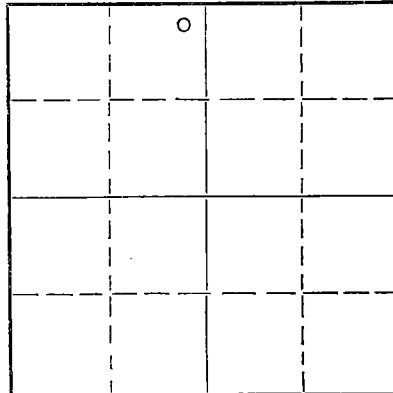

Locate well correctly on above
Section Plat

If a producing well is abandoned, date of last production 19

Was permission obtained from the Conservation Division or its agents before plugging was commenced? Yes

Name of Conservation Agent who supervised plugging of this well Derkey

Producing formation _____ Depth to top _____ Bottom _____ Total Depth of Well 4035 Feet

Show depth and thickness of all water, oil and gas formations.

OIL, GAS OR WATER RECORDS

CASING RECORD

FORMATION	CONTENT	FROM	TO	SIZE	PUT IN	PULLED OUT
		0	270	12 $\frac{1}{2}$	Cemented	
		0	560	8 5/8		318

Describe in detail the manner in which the well was plugged, indicating where the mud fluid was placed and the method or methods used in introducing it into the hole. If cement or other plugs were used, state the character of same and depth placed, from _____ feet to _____ feet for each plug set.

4035 to 560 Mud

560 to 526 Bridge

526 to 484 Cement

484 to 318 Mud

318 to bottom cellar cement

(If additional description is necessary, use BACK of this sheet)

Name of Plugging Contractor Badger Drillers, Inc.
Address Great Bend, Kansas

1-25-55

KENWOOD OIL COMPANY

KINAST #1

NE NE NW, Sec. 24-25S-4W,
Reno County, Kansas

Drilling Started 12-8-54
Drilling Completed 12-29-54

<u>From</u>	<u>To</u>	<u>Formation</u>	<u>Remarks</u>
0	20	Surface Soil	
20	180	Sand-Shale	
180	409	Shale	Cemented 270' 13 3/8" OD Casing
409	430	Sand	
430	445	Shale-Sand	
445	556	Shale	
556	5 60	Anhydrite	
560	630	Anhydrite-Shale	
630	660	Shale	
660	1070	Lime & Shale	
1070	1325	Lime	
1325	2816	Lime & Shale	
2816	3060	Lime	
3060	3214	Lime & Shale	
3214	3274	Lime	
3274	3411	Shale & Lime	
3411	3691	Mississippi Lime	
3691	3834	Shale	
3834	3891	Shale & Lime	
3891	3946	Sand & Shale	
3946	3966	Shale	
3966	3987	Sand & Shale	
3987	4035	Lime	T.D. 4035 - Dry Hole

This is a certified true copy of the Driller's log as shown on the Daily Drilling Reports.

J.C. Carman
Badger Drillers, Inc.

Subscribed and sworn to before me
this 21st day of Jan, 1955

Oral Gralich
Notary Public

My Commission expires 10-20-57

RECEIVED
STATE CORPORATION COMMISSION
JAN 22 1955
CONSERVATION DIVISION
Topeka, Kansas

PLUGGING
FILE SEC 4 T 25 R 4W
BOX PAGE 91 LINE 45