

STATE OF KANSAS  
CORPORATION COMMISSION


WELL PLUGGING RECORD

All Information Completely  
Make Required Affidavit  
Mail or Deliver Report to:  
Conservation Division  
State Corporation Commission  
211 No. Broadway  
Wichita, Kansas

Stafford County, Sec. 1 Twp. 25s Rge. 13 (X) (W)

Location as "NE/CNWxSWx" or footage from lines NW-SW-NE  
Lease Owner Leben Drilling, Inc.  
Lease Name Mather Well No. 1  
Office Address P.O. Box 486 Great Bend, Kansas  
Character of Well (completed as Oil, Gas or Dry Hole) Dry Hole  
Date well completed 7-13-61 19  
Application for plugging filed 7-13-61 19  
Application for plugging approved 7-13-61 19  
Plugging commenced 7-13-61 19  
Plugging completed 7-13-61 19  
Reason for abandonment of well or producing formation Dry Hole

NORTH

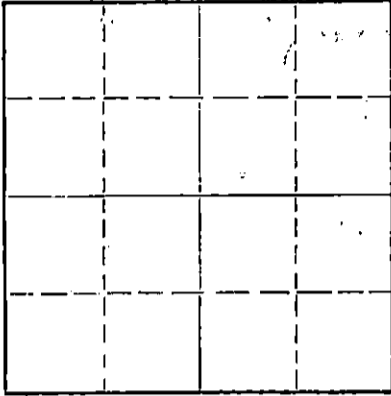

Locate well correctly on above  
Section Flat

If a producing well is abandoned, date of last production \_\_\_\_\_ 19\_\_\_\_  
Was permission obtained from the Conservation Division or its agents before plugging was com-  
menced? Yes

Name of Conservation Agent who supervised plugging of this well Frank Broadfoot  
Producing formation \_\_\_\_\_ Depth to top \_\_\_\_\_ Bottom \_\_\_\_\_ Total Depth of Well \_\_\_\_\_ Feet  
Show depth and thickness of all water, oil and gas formations.

OIL, GAS OR WATER RECORDS

CASING RECORD

FORMATION	CONTENT	FROM	TO	SIZE	PUT IN	PULLED OUT
				8 5/8"	259'	None

Describe in detail the manner in which the well was plugged, indicating where the mud fluid was placed and the method or methods used in introducing it into the hole. If cement or other plugs were used, state the character of same and depth placed, from \_\_\_\_\_ feet to \_\_\_\_\_ feet for each plug set.

1st Plug @ 255' w/ 1/2 sk hulls & 20 sks cement.  
2nd Plug @ 40' w/ 1/2 sk hulls & 10 sks cement.  
5 sks cement in rathole.

RECEIVED  
STATE CORPORATION COMMISSION

JUL 25 1961

CONSERVATION DIVISION  
Wichita, Kansas


(If additional description is necessary, use BACK of this sheet)  
Name of Plugging Contractor Leben Drilling, Inc.  
Address P.O. Box 486 Great Bend, Kansas

STATE OF Kansas COUNTY OF Barton, ss.  
Byron Johnson (employee of owner) or (owner or operator) of the above-described well, being first duly sworn on oath, says: That I have knowledge of the facts, statements, and matters herein contained and the log of the above-described well as filed and that the same are true and correct. So help me God.

(Signature) Byron Johnson  
P.O. Box 486 Great Bend, Kansas  
(Address)

SUBSCRIBED AND SWORN TO before me this 21 day of July, 1961

My commission expires April 1, 1963

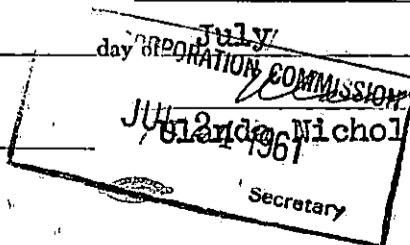

Notary Public.

COMPANY:  
CONTRACTOR:  
DATE:  
LOCATION:  
COMPLETION:  
COMPLETION:

LEBAN DRILLING, INC.  
LEBAN DRILLING, INC.  
WATERS # 1  
N/2 SEC. 2-255-134  
STAFFORD COUNTY, KANSAS  
7-9-61  
7-12-61

0	125	Sand & Gravel
125	253	Red Bed
253	1045	Shale & Red Bed
1045	1734	Shale
1734	1829	Shale & Lino
1829	2020	Lino
2020	2230	Lino & Shale
2230	2360	Lino
2360	3104	Lino & Shale
3104	3996	Lino
3996	4031	Lino, Shale & Chert
4031	4085	Lino & Chert
4085	4119	Lino
4119	4170	Lino & Chert
4170	4225	Simpson, Lino & Shale
4225	4230	Simpson, Lino & Shale
4230	4230	Rotary Total Depth - D & A

RECEIVED  
STATE CORPORATION COMMISSION  
AUG 14 1961  
CONSERVATION DIVISION  
Wichita, Kansas

Set 8 5/8" casing @ 257' with 850 cc cement.

I, Byron Johnson, do hereby certify that the above and foregoing is a true and correct copy of the log of the Waters #1, located N/2 of Section 1, Township 15S, Range 13 West, Stafford County, Kansas, as reflected by the files of Leban Drilling, Inc.

*Byron E. Johnson*  
Byron E. Johnson

STATE OF KANSAS )  
                          ) SS  
COUNTY OF BARTON)

Subscribed and sworn to before me, a Notary Public, in and for Barton County, Kansas, this 20th day of July, 1961.

*Wanda Nichols*  
Wanda Nichols

My Commission Expires  
April 1, 1963

STATE CORPORATION COMMISSION  
AUG 11 1961  
Secretary