


STATE OF KANSAS  
STATE CORPORATION COMMISSION

Give All Information Completely  
Make Required Affidavit  
Mail or Deliver Report to:  
Conservation Division  
State Corporation Commission  
800 Biting Building  
Wichita, Kansas

WELL PLUGGING RECORD

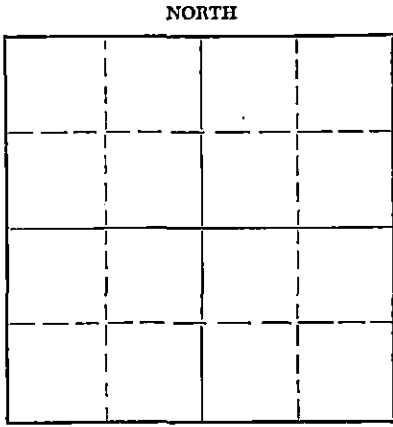

Locate well correctly on above  
Section Plat

Stafford County. Sec. 1 Twp. 25S Rge. (E) 13 (W)  
Location as "NE/CNWSW" or footage from lines SE SE SE  
Lease Owner Continental Oil Company  
Lease Name P. Mather "A" Well No. 1  
Office Address Box 161, Great Bend, Kansas  
Character of Well (completed as Oil, Gas or Dry Hole) Dry Hole  
Date well completed 4-6 19 59  
Application for plugging filed 4-7 19 59  
Application for plugging approved 4-7 19 59  
Plugging commenced 4-7 19 59  
Plugging completed 4-7 19 59  
Reason for abandonment of well or producing formation No commercial shows encountered.  
If a producing well is abandoned, date of last production \_\_\_\_\_ 19 \_\_\_\_  
Was permission obtained from the Conservation Division or its agents before plugging was commenced? yes

Name of Conservation Agent who supervised plugging of this well Mr. Broadfoot  
Producing formation none Depth to top \_\_\_\_\_ Bottom \_\_\_\_\_ Total Depth of Well 3850 Feet  
Show depth and thickness of all water, oil and gas formations.

OIL, GAS OR WATER RECORDS

CASING RECORD

FORMATION	CONTENT	FROM	TO	SIZE	PUT IN	PULLED OUT
<u>Lansing KC</u>	<u>Gas &amp; Water</u>	<u>3685</u>	<u>3735</u>	<u>10 3/4"</u>	<u>262'</u>	<u>None</u>
	<u>Gas &amp; Oil</u>	<u>3739</u>	<u>3786</u>			

Describe in detail the manner in which the well was plugged, indicating where the mud fluid was placed and the method or methods used in introducing it into the hole. If cement or other plugs were used, state the character of same and depth placed, from \_\_\_\_\_ feet to \_\_\_\_\_ feet for each plug set.

Mudded to top and ran wiper plug and pumped in  
100 sacks of cement (Halliburton).

RECEIVED  
STATE CORPORATION COMMISSION  
APR 9 1959  
CONSERVATION DIVISION  
Wichita, Kansas

(If additional description is necessary, use BACK of this sheet)  
Name of Plugging Contractor Garvey Drilling Company  
Address Wichita, Kansas

STATE OF Kansas, COUNTY OF Barton, ss.  
F. L. Dunn (employee of owner) or (~~owner~~) of the above-described well, being first duly sworn on oath, says: That I have knowledge of the facts, statements, and matters herein contained and the log of the above-described well as filed and that the same are true and correct. So help me God.

ARC  
4-8-59  
State DWM File  
(Signature) F. L. Dunn  
Box 161, Great Bend, Kansas  
(Address)

SUBSCRIBED AND SWORN TO before me this 8th day of April, 19 59

My commission expires 8-1-60  
[Signature] Notary Public.

24-7388-5 3-53-20M

PLUGGING  
FILE SEC. 1 T. 25 R. 13W  
BOOK PAGE 29 LINE 10

WELL LOG

COMPANY CONTINENTAL OIL COMPANY

SEC. 1 T. 25S R. 13W

FARM P. MATHER "A" NO. 1

LOC. SE, SE, SE


TOTAL DEPTH 3850'

COUNTY STAFFORD CO., KANSAS

COMM. March 27, 1959

COMP. April 7, 1959

CONTRACTOR GARVEY DRILLING COMPANY

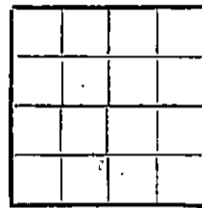

CASING 10 3/4" @ 266' W/225 sax.

ELEVATION 1914' DF

PRODUCTION D & A

FIGURES INDICATE BOTTOM OF FORMATIONS

104	Surface clay & sand
160	Sand & gravel
740	Red bed
770	Anhydrite
1160	Shale & shells
1676	Shale & lime
2080	Lime
2235	Shale & lime
2605	Shale
3185	Shale & lime
3441	Lime
3597	Shale & lime
3850	Lime
3850	T. D.



RECEIVED  
STATE CORPORATION COMMISSION

AUG 29 1966

CONSERVATION DIVISION  
Wichita, Kansas

State of KANSAS

County of BARTON

I, VERNE A. MORRIS of GARVEY DRILLING COMPANY

upon oath state that the above and foregoing is a true and correct copy of the log of the P. MATHER "A" #1 well

Subscribed and sworn to before me this 11th day of April 19 59

My Commission Expires: November 12, 1962

NOTARY PUBLIC

*Handwritten note:* Reproduction of this log by WEG REP DIVISION FILE