


STATE OF KANSAS
STATE CORPORATION COMMISSION

WELL PLUGGING RECORD

Give All Information Completely
Make Required Affidavit
Mail or Deliver Report to
Conservation Division
State Corporation Comm.
245 North Water
Wichita, KS 67202

Stafford County, Sec. 3 Twp. 25 Rge. 13 E/W
Location as "NE/CNW $\frac{1}{4}$ SW $\frac{1}{4}$ " or footage from lines
NW NE NW
Lease Owner Brougher Oil Co.
Lease Name Bell A- 1-A Well No. _____
Office Address Great Bend, Kansas 67530
Character of Well (Completed as Oil, Gas or Dry Hole) _____

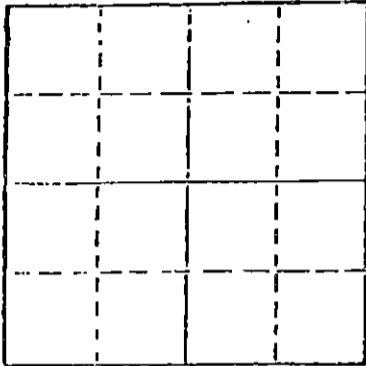

Locate well correctly on above
Section Plat

Date Well completed 19____
Application for plugging filed 19____
Application for plugging approved 19____
Plugging commenced 6/20/80 19____
Plugging completed 7/10/80 19____
Reason for abandonment of well or producing formation
depleted
If a producing well is abandoned, date of last production 19____

Was permission obtained from the Conservation Division or
its agents before plugging was commenced? yes

Name of Conservation Agent who supervised plugging of this well Owens
Producing formation _____ Depth to top _____ Bottom _____ Total Depth of Well 4247
Show depth and thickness of all water, oil and gas formations.

OIL, GAS OR WATER RECORDS

CASING RECORD

FORMATION	CONTENT	FROM	TO	SIZE	PUT IN	PULLED OUT
				8-5/8	264	none
				4 $\frac{1}{2}$ "	4240	3422'

Describe in detail the manner in which the well was plugged, indicating where the mud fluid was placed and the method or methods used in introducing it into the hold. If cement or other plugs were used, state the character of same and depth placed, from _____ feet to _____ feet for each plug set.

Squeezed 4 $\frac{1}{2}$ " casing with 35 sacks cement. Pumped plug to 3450' and shot pipe at 3525', 3405', pulled 83 joints. Squeezed hole with 15 sacks gel, 8 sacks hulls and 10 sacks gel. Released plug and displaced with 100 sacks 50-50 pozmix, 4% gel and 3% cc.

PLUGGING COMPLETE.

(If additional description is necessary, use BACK of this sheet)

Name of Plugging Contractor KESLO CASING PULLING
CHASE, KANSAS


STATE OF KANSAS COUNTY OF RICE, ss.
R. DARRELL KESLO (employee of owner) or (owner or operator)
of the above-described well, being first duly sworn on oath, says: That I have knowledge of the facts, statements, and matters herein contained and the log of the above-described well as filed and that the same are true and correct. So help me God.

(Signature) *R. Darrell Keslo*
CHASE, KANSAS (Address)

SUBSCRIBED AND SWORN TO before me this 17th day of July, 1980

Margaret Melcher
Notary Public.

My commission expires _____

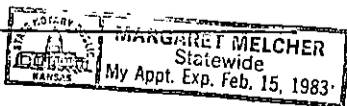

RECEIVED
STATE CORPORATION COMMISSION

JUL 18 1980

CONSERVATION DIVISION
Wichita, Kansas