


STATE OF KANSAS
STATE CORPORATION COMMISSION

Give All Information Completely
Make Required Affidavit
Mail or Deliver Report to:
Conservation Division
State Corporation Commission
211 No. Broadway
Wichita, Kansas

WELL PLUGGING RECORD

NORTH

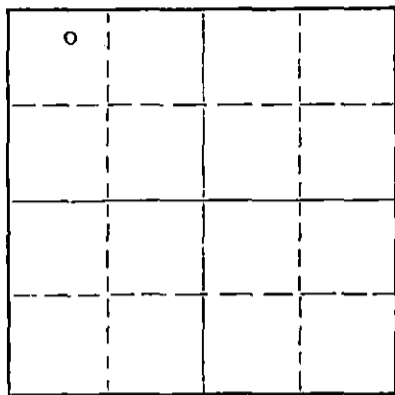

Locate well correctly on above
Section Plot

Stafford County, Sec. 3 Twp. 25S Rge. 13W (E) (W)
Location as "NE/CNW%SW%" or footage from lines NE NW NW
Lease Owner Hellar Drilling Company, Inc.
Lease Name Halley Well No. 1-B
Office Address 1014 Union Center, Wichita, Kansas 67202
Character of Well (completed as Oil, Gas or Dry Hole) Dry Hole
Date well completed May 7 19 66
Application for plugging filed May 7 19 66
Application for plugging approved May 7 19 66
Plugging commenced May 9 19 66
Plugging completed May 9 19 66
Reason for abandonment of well or producing formation Dry Hole

If a producing well is abandoned, date of last production _____ 19____
Was permission obtained from the Conservation Division or its agents before plugging was commenced? Yes

Name of Conservation Agent who supervised plugging of this well Archie V. Elving, Pratt, Kansas
Producing formation _____ Depth to top _____ Bottom _____ Total Depth of Well 4256 Feet
Show depth and thickness of all water, oil and gas formations.

OIL, GAS OR WATER RECORDS

CASING RECORD

FORMATION	CONTENT	FROM	TO	SIZE	PUT IN	PULLED OUT
		0	251'	8 5/8"	251'	None

Describe in detail the manner in which the well was plugged, indicating where the mud fluid was placed and the method or methods used in introducing it into the hole. If cement or other plugs were used, state the character of same and depth placed, from _____ feet to _____ feet for each plug set.

Set Plug: 240'/25 sacks cement/1/2 sack hulls
40'/10 sacks cement/1/2 sack hulls

RECEIVED
STATE CORPORATION COMMISSION
MAY 23 1966
CONSERVATION DIVISION
Wichita, Kansas

(If additional description is necessary, use BACK of this sheet)

Name of Plugging Contractor Hellar Drilling Company, Inc.
Address 1014 Union Center, Wichita, Kansas 67202

STATE OF Kansas, COUNTY OF Sedgwick, ss.
D. L. Hellar, President of Hellar Drilling Co. Inc. (employee of owner) or (owner or operator) of the above-described well, being first duly sworn on oath, says: That I have knowledge of the facts, statements, and matters herein contained and the log of the above-described well as filed and that the same are true and correct. So help me God.

(Signature) D. L. Hellar D. L. Hellar, President
1014 Union Center, Wichita, Kansas 67202
(Address)

SUBSCRIBED AND SWORN TO before me this 19th day of May, 1966

My commission expires March 25, 1968

Catherine Darcey Notary Public.

DRILLER'S LOG

COMPANY: Hellar Drilling Company, Inc., Wichita, Kansas
 CONTRACTOR: Hellar Drilling Company, Inc.
 LEASE: #1 Halley 'B'
 LOCATION: NE NW NW 3-25S-13W, Stafford County, Kansas
 COMMENCED: April 27, 1966
 COMPLETED: May 7, 1966
 CASING: Set 8 5/8" surface casing @ 251'/250 sacks cement

0-253	Surface sand, clay shale
253-813	Red Bed
813-828	Anhydrite
828-930	Red Bed
930-1541	Red Bed & shale & shells
1541-1725	Salt Section
1725-1859	Lime & Shale
1859-2194	Ft. Riley chert
2194-2345	Lime & shale
2345-2545	Shale & lime
2545-3235	Lime & shale
3235-3363	Topeka Lime Section
3363-3508	Lime & shale
3508-3622	Shale
3622-3672	Lime & shale
3672-3777	Lime
3777-3791	K. C. lime
3791-3870	Lime
3870-3905	K. C. lime
3905-3926	Lime
3926-4000	Lime & shale
4000-4001	Shale-lime streaks
4001-4080	Lime- cherty
4080-4114	Viola Lime & chert
4114-4177	Lime & chert
4177-4224	Simpson sand & shale
4224-4256	Dolomite
4256	Rotary Total Depth
	D & A

RECEIVED
 STATE PRODUCTION COMMISSION
 MAY 23 1966
 CONSERVATION DIVISION
 Wichita, Kansas

STATE OF KANSAS)
) SS
 COUNTY OF SEDGWICK)

I, D. L. Hellar, do hereby certify that the above and foregoing is a true and correct copy of the log of the #1 Halley 'B', located in NE NW NW 3-25S-13W, Stafford County, Kansas, as reflected by the files of the Hellar Drilling Company, Inc.

HELLAR DRILLING COMPANY, INC.

By D. L. Hellar
 President - D. L. Hellar

Subscribed and sworn to before me, a Notary Public, in and for Sedgwick County, Kansas, this 19th day of May, 1966.

Catherine Darcey
 Notary Public - Catherine Darcey

My Commission Expires:
 March 25, 1968.