

STATE OF KANSAS
STATE CORPORATION COMMISSION


WELL PLUGGING RECORD

All Information Completely
Made Required Affidavit
Mail or Deliver Report to:
Conservation Division
State Corporation Commission
800 Bitting Building
Wichita, Kansas

OR
FORMATION PLUGGING RECORD

Strike out upper line
when reporting plug-
ging of formations.

NORTH

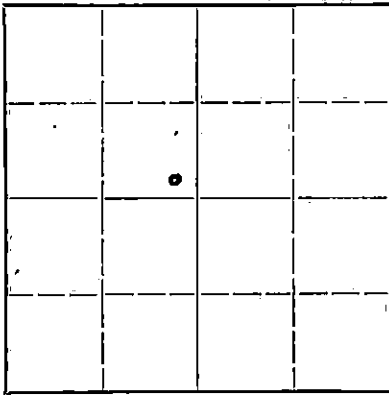

Locate well correctly on above
Section Flat

Location as Stafford County. Sec. 4 Twp. 25 S Rge. 12 (E) W (W)
Location as "NE 1/4 NW 1/4 SW 1/4" or footage from lines. SE SE NW
Lease Owner. W. P. Craulmer
Lease Name. Cadman Well No. 1
Office Address. 521 First Nat Bank Bldg Wichita Kansas
Character of Well (completed as Oil, Gas or Dry Hole). Striper
Date well completed. February 7, 1944 19
Application for plugging filed. Nov 30 19 47
Application for plugging approved. " " 19 " "
Plugging commenced. Dec 3 19 47
Plugging completed. Dec 30 19 47
Reason for abandonment of well or producing formation. Striper well

If a producing well is abandoned, date of last production: June 1947 19
Was permission obtained from the Conservation Division or its agents before plugging was com-
menced? yes

Name of Conservation Agent who supervised plugging of this well. H. H. Kern
Producing formation. 4066' to 4083' Depth to top. 4066' Bottom. 4083' Total Depth of Well 4083' Feet
Show depth and thickness of all water, oil and gas formations.


OIL, GAS OR WATER RECORDS

CASING RECORD

Formation	Content	From	To	Size	Put In	Pulled Out
<u>Viola</u>	<u>10</u>			<u>10 3/4</u> <u>5 1/2</u>	<u>336'</u> <u>4066'</u>	<u>None</u> <u>3150'</u>

Describe in detail the manner in which the well was plugged, indicating where the mud fluid was placed and the method or methods used in introducing it into the hold. If cement or other plugs were used, state the character of same and depth placed, from _____ feet to _____ feet for each plug set.

Plugged from 4050' to 4083' - 5 sacks sand + 5 sacks cement
mud from 750' to 4050' cement plug from 720' to 750'
mud from 250' to 720' cement plug from 210' to 250'
mud from 18' to 210' - 10 sacks cement from surface
to 18' capping hole

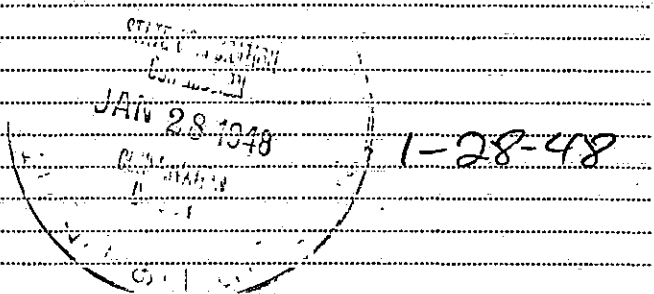


(If additional description is necessary, use BACK of this sheet)
Correspondence regarding this well should be addressed to W. P. Craulmer 521 First Nat Bank
Address. Bldg Wichita Kansas

STATE OF Kansas, COUNTY OF Bedford, ss.
_____, (employee of owner) or (owner or operator) of the above-described well,
being first duly sworn on oath, says: That I have knowledge of the facts, statements, and matters herein contained and the log of the above-
described well as filed and that the same are true and correct. So help me God.

(Signature) W. P. Craulmer
1415 Jackson St Street Bend Kans
(Address)

SUBSCRIBED AND SWORN to before me this 28th day of January, 1948.
Wilma M. Ballard
Notary Public.

My commission expires November 10, 1951

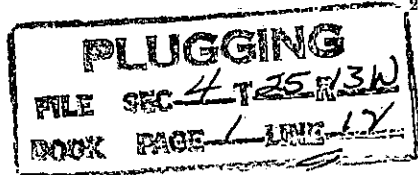

WELL LOG

Cadman

Company: Faulkner Oil Company--Wichita, Kansas.
 Contractor: Campbell & Kuhn-- Wichita, Kansas.
 Lease: Cadman- Well # 1 Stafford County, Kansas.
 Surface Pipe:
 Pay string :
 Well started: Dec. 12, 1943---Finished: 2-7-44

From	To	
0	9	Cellar
9	50	Sand (soft)
50	156	Sand (soft)
156	175	Sand (hard)
175	235	Red Bed & shale
235	323	Shale & shells
323	375	
375	550	Set 323 feet of 10 3/4" casing & cemented with 175 sacks Common bulk
550	685	Red Bed
685	785	Shale & shells
785	1125	Shale & shells
1125	1300	Salt & shale
1300	1455	Shale & shells
1455	1663	Shale & shells
1663	1669	Lime
1669	1830	Lime & shale
1830	1960	Shale & lime
1960	2035	Lime & shale
2035	2055	Shale (sticky)
2055	2070	Lime & shale
2070	2175	Lime & shale
2175	2275	Lime & shale
2275	2370	Shale & lime
2370	2435	Lime & shale
2435	2535	Lime & shale
2535	2625	Lime & shale
2625	2740	Lime & shale
2740	2845	Lime & shale
2845	2907	Shale & lime
2907	2955	Lime & shale
2955	2995	Shale & lime
2995	3090	Shale & lime
3090	3135	Shale & lime
3135	3155	Lime
3155	3213	Lime
3213	3249	Lime
3249	3285	Lime
3285	3340	Lime
3340	3375	Lime
3375	3397	Lime
3397	3425	Lime
3425	3465	Lime
3465	3520	Lime
3520	3565	Lime
3565	3613	Lime & shale
3613	3655	Lime & shale
3655	3695	Lime & shale
3695	3729	Lime & shale
3729	3771	Lime
3771	3775	Shale
3775	3789	Lime
3789	3801	Shale
3801	3821	Shale & lime
3821	3842	Lime
3842	3855	Shale
3855	3873	Lime
3873	3903	Lime
3903	3927	Lime
3927	3933	Shale
3933	3941	Shale
3941	3965	Shale
3965	3971	Shale
3971	3975	Cherty Line
3975	3992	Shale
3992	4014	Shale
4014	4038	Shale
4038	4040	Shale
4040	4055	Cherty conglomerate.

PLUGGING
 FILE SEC 4 T 25 R 13W
 BOOK PAGE 1 LINE 12

NOV 28 1947

From	To	
4055	4069	Cherty Congl.
4059	4075	Lime
4075	4076	Cherty Lime
4076	4077	Cherty lime
4077	4090	T.D. 25 Jts 6 1/2" casing & 109 Jts 6 1/2" casing
3137		Milling on casing --Fishing
3137	3138-11	Milling on casing
3138-11	3140-10	Milling on casing
3140-10	3142-06	Milling on casing
3142-06	3145-11	Milling on casing
3145-11	3150	Milling on casing
3150	3151	Fishing on casing
3151	3155-7	Milling on casing
3155-7	3156-7	Reaming hole & conditioning mud
3156-7	3158-7	Milling on casing
3158-7	3161-06	Milling on casing
3161-6	3166-5	Milling on casing
3166-5	3169-5	Fishing for casing
3169-5	3180	Milling on casing
3180	3183-5	Coring with bit
3044	3052	Cement --Sidetracking
3052	3067	Shale & lime
3062	3067	Reaming to 9"
3067	3082	
3082	3114	Shale
3114	3148	Shale
3148	3195	Lime
3195	3250	Lime
3250	3295	Lime
3295	3375	Lime
3375	3410	Lime
3410	3450	Lime
3450	3490	Lime
3490	3545	Lime
3545	3585	Lime
3585	3615	Lime
3615	3660	Lime & shale
3660	3675	Lime & shale
3675	3720	Lime & shale
3720	3770	Lime
3770	3815	Lime & shale
3815	3830	Lime
3830	3850	Shale
3850	3865	Lime
3865	3880	Lime
3880	3895	Lime & shale
3895	3910	Lime
3910	3934	Lime
3934	3946	Shale
3946	3979	Shale
3979	3997	Shale
3997	4015	Shale
4015	4044	Shale
4044	4058	Shale
4058	4071	Lime
4071	4083	Lime --Circulating
4080		T.D. Run 70 jts Casing

I hereby certify that the above log was taken from the drilling reports of the Cadman # 1 Stafford County, Kansas.

NOV 26 1947