


WELL PLUGGING RECORD

Give All Information Completely
Make Required Affidavit
Mail or Deliver Report to:
Conservation Division
State Corporation Commission
211 No. Broadway
Wichita, Kansas

Stafford County, Sec. 4 Twp. 25 Rge. 13W (E) (W)

Location as "NE/CNW/SW" or footage from lines NE NW SW
Lease Owner Beardmore Drilling Company
Lease Name Cornwell Well No. 1
Office Address 827 Beacon Building, Wichita, Kansas 67202
Character of Well (completed as Oil, Gas or Dry Hole) Dry Hole
Date well completed May 24 19 64
Application for plugging filed May 24 19 64
Application for plugging approved May 24 19 64
Plugging commenced May 24 19 64
Plugging completed May 24 19 64
Reason for abandonment of well or producing formation Dry Hole

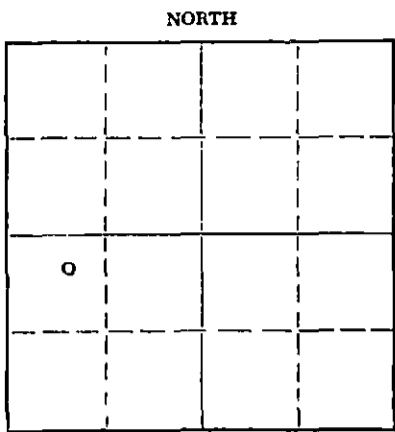

Locate well correctly on above Section Plat

If a producing well is abandoned, date of last production 19
Was permission obtained from the Conservation Division or its agents before plugging was commenced? Yes

Name of Conservation Agent who supervised plugging of this well Archie V. Elving, Pratt, Kansas
Producing formation _____ Depth to top _____ Bottom _____ Total Depth of Well _____ Feet
Show depth and thickness of all water, oil and gas formations.

OIL, GAS OR WATER RECORDS

CASING RECORD

FORMATION	CONTENT	FROM	TO	SIZE	PUT IN	PULLED OUT
		0	358'	8 5/8"	358'	None

Describe in detail the manner in which the well was plugged, indicating where the mud fluid was placed and the method or methods used in introducing it into the hole. If cement or other plugs were used, state the character of same and depth placed, from _____ feet to _____ feet for each plug set.

Set Plug @ 275'/25 sacks cement, 1/4 sack hulls
40'/10 sacks cement, 1/4 sack hulls
and put 2 sacks cement in Rat Hole.

RECEIVED
STATE CORPORATION COMMISSION

JUN 2 1968

CONSERVATION DIVISION
Wichita, Kansas

6-2-64

(If additional description is necessary, use BACK of this sheet)

Name of Plugging Contractor Hellar Drilling Company, Inc.
Address 1014 Union Center, Wichita, Kansas 67202

STATE OF Kansas COUNTY OF Sedgwick, ss.
D. L. Hellar, Pres. of Hellar Drilling Co. Inc.

(employee of owner) or (owner or operator) of the above-described well, being first duly sworn on oath, says: That I have knowledge of the facts, statements, and matters herein contained and the log of the above-described well as filed and that the same are true and correct. So help me God.

(Signature) D. L. Hellar D. L. Hellar, President
1014 Union Center, Wichita, Kansas 67202

(Address)

SUBSCRIBED AND SWORN TO before me this 28th day of May, 19 64

My commission expires March 25, 1968

Catherine Darcey
Catherine Darcey - Notary Public.

RECEIVED
STATE CORPORATION COMMISSION

JUN 2 1964

CONSERVATION DIVISION
Wichita, Kansas

DRILLER'S LOG

COMPANY:	Beardmore Drilling Company
CONTRACTOR:	Hellar Drilling Company, Inc.
LEASE:	#1 Cornwell
LOCATION:	NE NW SW 4-25-13W, Stafford County, Kansas
COMMENCED:	May 15, 1964
COMPLETED:	May 24, 1964
CASING:	Set @ 8 5/8" surface casing @ 358' / 275 sacks cement

0-160	Sand
160-358	Red Bed
358-834	Red Bed & shale
834-839	Anhydrite
839-844	Shale
844-1299	Red Bed & shale
1299-1890	Shale
1890-2040	Lime & Shale
2040-2177	Ft. Riley
2177-3688	Lime & Shale
3688-3809	Lime
3809-3852	L. K.C.
3852-3912	Lime
3912-3972	Lime w/shale stks.
3972-4025	Lime & Shale
4025	Rotary Total Depth
	Dry and Abandoned

RECEIVED
STATE CORPORATION COMMISSION

JUN 2 1964

CONSERVATION DIVISION
Wichita, Kansas

STATE OF KANSAS)
) SS
 COUNTY OF SEDGWICK)

I, D. L. Hellar, do hereby certify that the above and foregoing is a true and correct copy of the log of the #1 Cornwell, located in NE NW SW 4-25-13W, Stafford County, Kansas, as reflected by the files of the Hellar Drilling Company, Inc.

HELLAR DRILLING COMPANY, INC.

By *D. L. Hellar*
President - D. L. Hellar

Subscribed and sworn to before me, a Notary Public, in and for Sedgwick County, Kansas, this 28th day of May, 1964.

My Commission Expires:
March 25, 1968.

Catherine Darcey
Notary Public - Catherine Darcey