


STATE OF KANSAS
STATE CORPORATION COMMISSION

WELL PLUGGING RECORD

Give All Information Completely
Make Required Affidavit
Mail or Deliver Report to
Conservation Division
State Corporation Comm.
245 North Water
Wichita, KS 67202

Stafford County, Sec. 4 Twp. 25 Rge. 13 E/W
Location as "NE/CNW $\frac{1}{4}$ SW $\frac{1}{4}$ " or footage from lines
350' NW - 55 SE NW
Lease Owner Bill Cottle
Lease Name Cottle Well No. 1
Office Address _____
Character of Well (Completed as Oil, Gas or Dry Hole) _____
Date Well completed 6-13-1978
Application for plugging filed _____ 19____
Application for plugging approved 6-13-1978
Plugging commenced _____ 19____
Plugging completed 6-13-1978
Reason for abandonment of well or producing formation D+A
If a producing well is abandoned, date of last production _____ 19____

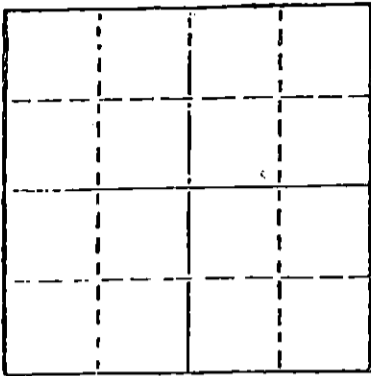

Locate well correctly on above
Section Flat

Name of Conservation Agent who supervised plugging of this well: Bill Owen
Producing formation _____ Depth to top _____ Bottom _____ Total Depth of Well 4270
Show depth and thickness of all water, oil and gas formations.

OIL, GAS OR WATER RECORDS

CASING RECORD

FORMATION	CONTENT	FROM	TO	SIZE	PUT IN	PULLED OUT
				<u>8-5/8</u>	<u>396</u>	

Describe in detail the manner in which the well was plugged, indicating where the mud fluid was placed and the method or methods used in introducing it into the hold. If cement or other plugs were used, state the character of same and depth placed, from _____ feet to _____ feet for each plug set.

Mud to 600' - 40 sacks Cement RECEIVED

Mud to 390' - 35 sacks Cement STATE CORPORATION COMMISSION

Mud to 40", bridge w/ hulls, plug and 12 sacks Cement

3 sacks Cement in rat hole

3 sacks in mouse hole

CONSERVATION DIVISION
Wichita, Kansas

NOV - 6 1978
11-6-78

CONSERVATION DIVISION
Wichita, Kansas

(If additional description is necessary, use BACK of this sheet)

Name of Plugging Contractor Bill M. Kelly CO, Box 846,
Independence, KS

STATE OF Kansas COUNTY OF Stafford, ss.
(employee of owner) or (owner or operator)
of the above-described well, being first duly sworn on oath, says: That I have knowledge of the facts, statements, and matters herein contained and the log of the above-described well as filed and that the same are true and correct. So help me God.

(Signature) Warren Taylor

(Address) _____

SUBSCRIBED AND SWORN TO before me this 20 day of SEPTEMBER, 19 78



Warren Taylor
Notary Public.

My commission expires MARCH 25, 1982