


STATE OF KANSAS
STATE CORPORATION COMMISSION

Give All Information Completely
Make Required Affidavit
Mail or Deliver Report to:
Conservation Division
State Corporation Commission
800 Bittling Building
Wichita, Kansas

WELL PLUGGING RECORD

NORTH

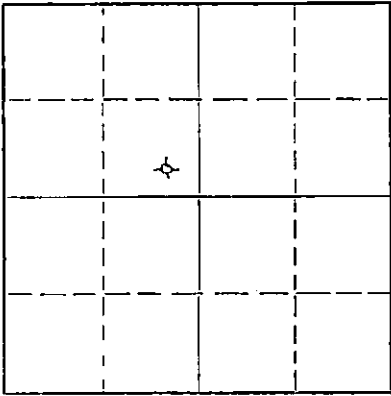

Locate well correctly on above
Section Plot

Stafford County, Sec. 9 Twp 25S Rge. 13 (E) W (W)
Location as "NE/CNW/SW" or footage from lines SE/4 SE/4 NW/4
Lease Owner Lawson Petroleum Company
Lease Name Cornwell Well No. 1
Office Address 2001 Philtower Building, Tulsa, Oklahoma
Character of Well (completed as Oil, Gas or Dry Hole) Dry Hole
Date well completed April 22 19 53
Application for plugging filed (Verbal) April 22 19 53
Application for plugging approved (Verbal) April 22 19 53
Plugging commenced April 22 19 53
Plugging completed April 22 19 53
Reason for abandonment of well or producing formation Dry hole

If a producing well is abandoned, date of last production 19
Was permission obtained from the Conservation Division or its agents before plugging was commenced? Yes

Name of Conservation Agent who supervised plugging of this well M. A. Rives
Producing formation Arbuckle Dolomite Test Depth to top Bottom Total Depth of Well 4320 Feet
Show depth and thickness of all water, oil and gas formations.


OIL, GAS OR WATER RECORDS

CASING RECORD

FORMATION	CONTENT	FROM	TO	SIZE	PUT IN	PULLED OUT
		0	345'	8 5/8"	345'	None

Describe in detail the manner in which the well was plugged, indicating where the mud fluid was placed and the method or methods used in introducing it into the hole. If cement or other plugs were used, state the character of same and depth placed, from feet to feet for each plug set.


Plug hole. Bottom plug at 300' with 20 sacks of cement mixed and poured through drill pipe. Top plug at 40' with 10 sacks cement.

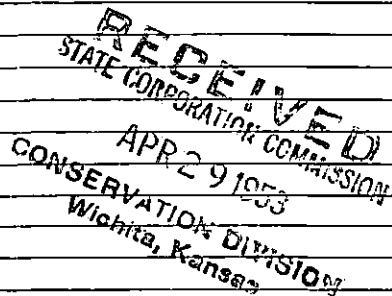

(If additional description is necessary, use BACK of this sheet)
Name of Plugging Contractor Birmingham-Bartlett Drilling Co.
Address 300 Kaufman Building, Wichita 2, Kansas

STATE OF Kansas, COUNTY OF Sedgewick
Richard Hindery, partner of Birmingham-Bartlett Drilling Co., contractor for
well, being first duly sworn on oath, says: That I have knowledge of the facts, statements, and matters herein contained and the log of the above-described well as filed and that the same are true and correct. So help me God BIRMINGHAM-BARTLETT DRILLING CO.
(Signature) By Richard Hindery
300 Kaufman Building, Wichita 2, Kansas
(Address)

SUBSCRIBED AND SWORN TO before me this 24th day of April, 19 53
My commission expires October 2, 1954
Beverly Larson
Notary Public.

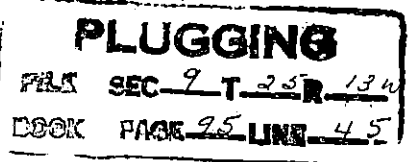

CORNWELL NO. 1 WELL

LOCATION: SE/4 SE/4 NW/4
Section 9-25S-13W
Stafford County, Kansas
SPUDDED: 4-8-53
COMPLETED: 4-22-53
OPERATOR: Lawson Petroleum Company
2001 Philtower Building
Stafford County, Kansas
CONTRACTOR: Birmingham-Bartlett Drilling Co.
SURFACE CASING: 8 5/8" 24# casing cemented at 345'
with 225 sacks cement and 3 cc.

L O G

(Figures indicate bottom of formation)

0 - 170	Sand
820	Red bed and shells
845	Anhydrite
1800	Shale and shells
2400	Broken lime
2555	Shale and lime
3195	Shale and shells
3275	Shale and lime
3550	Lime
3665	Shale
4070	Lime
4101	Shale and sand
4156	Lime
4175	Chert
4218	Chert and lime
4250	Lime
4266	Sand and shale
4290	Lime and shale
4320	Lime
4320	RTD - Dry & Abandoned

The undersigned, Richard Hindery, one of the partners of Birmingham-Bartlett Drilling Co., hereby certifies that the above is a true and correct log of the formations encountered in drilling the Cornwell No. 1 Well as shown in the daily drilling reports.

BIRMINGHAM-BARTLETT DRILLING CO.

By Richard Hindery

Subscribed and sworn to before me
this 24th day of April, 1953.

Beverly Larson
Notary Public

My commission expires October 2, 1954

PLUGGING

FILE, SEC. 9, T. 25, R. 13W

APR 29 1953

CONSERVATION DIVISION
Wichita, Kansas