

STATE OF KANSAS
STATE CORPORATION COMMISSION


WELL PLUGGING RECORD

Give All Information Completely
Make Required Affidavit
Mail or Deliver Report to:
Conservation Division
State Corporation Commission
800 Biting Building
Wichita, Kansas

Stafford County, Sec. 8 Twp. 25 Rge. 13 (W)

Location as "NE/CNW/SW" or footage from lines C, SW SW SW
Lease Owner E. K. Carey Contractor
Lease Name O'dell Well No. 1
Office Address Box 620, McPherson, Kansas
Character of Well (completed as Oil, Gas or Dry Hole) Oil
Date well completed October 9, 1955
Application for plugging filed May 25, 1956
Application for plugging approved May 28, 1956
Plugging commenced May 27, 1956
Plugging completed June 2, 1956
Reason for abandonment of well or producing formation Non Commercial

NORTH

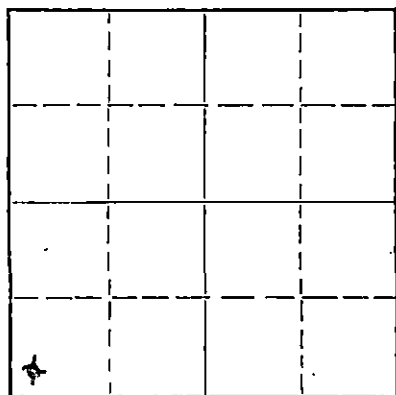

Locate well correctly on above
Section Plat

If a producing well is abandoned, date of last production May 16, 1956
Was permission obtained from the Conservation Division or its agents before plugging was commenced? Yes

Name of Conservation Agent who supervised plugging of this well Mr. Brundridge
Producing formation _____ Depth to top _____ Bottom _____ Total Depth of Well 4300 Feet
Show depth and thickness of all water, oil and gas formations.

OIL, GAS OR WATER RECORDS

CASING RECORD

FORMATION	CONTENT	FROM	TO	SIZE	PUT IN	PULLED OUT
				8-5/8	334'	None
				5-1/2	4289'	3629'

Describe in detail the manner in which the well was plugged, indicating where the mud fluid was placed and the method or methods used in introducing it into the hole. If cement or other plugs were used, state the character of same and depth placed, from _____ feet to _____ feet for each plug set.

Filled back to 4280' and dumped 5 sacks of cement. Shot pipe off at 3629'. Pulled pipe and squeezed surface pipe with 20 sacks of mud and 2 sacks of cotton seed hulls and 90 sacks of cement with Halliburton.

RECEIVED
STATE CORPORATION COMMISSION
JULY 2 1956
6-9-56
CONSERVATION DIVISION
WICHITA, KANSAS

(If additional description is necessary, use BACK of this sheet)

Name of Plugging Contractor _____
Address _____

STATE OF Kans. COUNTY OF Reno, ss.
Employee (employee of owner) or (owner or operator) of the above-described well, being first duly sworn on oath, says: That I have knowledge of the facts, statements, and matters herein contained and the log of the above-described well as filed and that the same are true and correct. So help me God.

(Signature) [Signature]
R. R. #4, Hutchinson, Kans.
(Address)

SUBSCRIBED AND SWORN TO before me this 4th day of June, 19 56
August 12, 1957

My commission expires _____
Notary Public.

PLUGGING
FILE SEC. 8 T. 25 R. 13W
BOOK PAGE 65 LINE 23

ROTARY DRILLER'S LOG

E. K. Carey, Contractor
Box 620
McPherson, Kansas

1962 K.B.
Elevations: 1959 D.P.
1957 Gr.

Odell #1

C, SW SW SW,
Sec. 8-25-13W,
Stafford County, Kansas

Well Commenced: 9-23-55
Well Completed: 10-9-55

8-5/8" x 5 1/2" Head 7.00'
below K. B.

Casing Record:

8-5/8" @ 333' w/250 sks
50% Pozmix and Common mixed
with 400# cc.

5-1/2" 4289' w/100 sks
Pozmix cemented 11' off bottom.

Contractor: E. K. Carey Contractor, Rig #1, Box 620, McPherson, Kansas
Geologist: Don Hollar, E. K. Carey Drlg. Co., 818 Central Bldg. Wichita.

Figures Indicate Bottom of Formation K. B.

Base and cellar	8
Sand	135
Shale and shells	333
Shale and red bed	550
Shale	805
Anhydrite	830
Shale	1130
Salt	1210
Shale and lime	1870
Lime	2200
Lime and shale	2630
Shale and lime	2980
Lime and shale	3100
Shale and lime	3250
Lime	3375
Lime and shale	3679
Kansas City lime	3695
Lime	3969
Lime and shale	4030
Chert and Congl.	4047
Shale and chert	4070
Shale and lime	4115
Lime	4213
Sand and chert	4226
Lime and shale	4289
Lime (Arbuckle)	4290
Lime	4300 TD

Geologist Tops:

Top Heebner	3512
Brown lime	3660
Lansing	3684
Congl.	4020
Weathered "lss.	4038
Viola	4106
Arbuckle	4285
Rotary Total Depth	4300

Ran 5 1/2" with Larkin Cementrol shoe
at 4289 or 11 feet off bottom.

DST - 3916-37 or 21' anchor. Open 1 hr.
Recovered 30' slightly oil cut mud and
60' salt water. 20 min. PWP 935#.

DST - 4289-4300' or 11' anchor. Open
1 hr. Recovered 1380' gas, 480' clean
oil, 60' oil cut mud and 120' water.
20 min. PWP 1250# FPP 125#.

WED
OCT 11 1955

This is to certify that the above information is to the best of my
knowledge true and correct.

SUBSCRIBED AND SWORN to before me this 11th day of October, 1955.

E. K. CAREY CONTRACTOR

BY Herbert Photon
Herbert Photon, Superintendent

Odell #1

NP

My Commission Expires: November 13, 1956

PLUGGING
FILE SEC 8 T25 R13W
BOOK PAGE 65 LINE 23