

STATE OF KANSAS
STATE CORPORATION COMMISSION


WELL PLUGGING RECORD

Give All Information Completely
Make Required Affidavit
Mail or Deliver Report to:
Conservation Division
State Corporation Commission
211 No. Broadway
Wichita, Kansas

Stafford County, Sec. 8 Twp 25S Rge. 13W (E) (W)

Location as "NE/CNW%SW%" or footage from lines NW SW SW
Lease Owner Richardson & McCandless
Lease Name O'Dell Well No. 1
Office Address 502 Union Center Bldg., Wichita, Kansas 67202
Character of Well (completed as Oil, Gas or Dry Hole) Dry Hole
Date well completed January 29 19 68
Application for plugging filed January 29 19 68
Application for plugging approved January 29 19 68
Plugging commenced January 29 19 68
Plugging completed January 29 19 68
Reason for abandonment of well or producing formation Dry Hole

NORTH

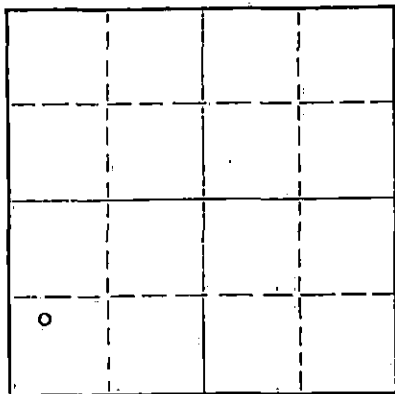

Locate well correctly on above
Section Plat

If a producing well is abandoned, date of last production 19
Was permission obtained from the Conservation Division or its agents before plugging was commenced? Yes

Name of Conservation Agent who supervised plugging of this well A. Elving, Box 248, Pratt, Kansas
Producing formation Depth to top Bottom Total Depth of Well 4313 1/2 Feet
Show depth and thickness of all water, oil and gas formations.

OIL, GAS OR WATER RECORDS

CASING RECORD

FORMATION	CONTENT	FROM	TO	SIZE	PUT IN	PULLED OUT
		0	250'	8 5/8"	250'	None

Describe in detail the manner in which the well was plugged, indicating where the mud fluid was placed and the method or methods used in introducing it into the hole. If cement or other plugs were used, state the character of same and depth placed, from feet to feet for each plug set.

Plug:

225'/25 sacks cement & 5 sacks hulls
40'/10 sacks cement & sack hulls

RECEIVED
STATE CORPORATION COMMISSION
FEB 2 - 1968
CONSERVATION DIVISION
Wichita, Kansas

(If additional description is necessary, use BACK of this sheet)

Name of Plugging Contractor Hellar Drilling Company, Inc.
Address 1014 Union Center, Wichita, Kansas 67202

STATE OF Kansas, COUNTY OF Sedgwick, ss.
D. L. Hellar, Pres. of Hellar Drlg. Co. Inc. (employee of owner) or (owner or operator) of the above-described well, being first duly sworn on oath, says: That I have knowledge of the facts, statements, and matters herein contained and the log of the above-described well as filed and that the same are true and correct. So help me God.

(Signature) D. L. Hellar, President
1014 Union Center Bldg., Wichita, Kansas 67202
(Address)

SUBSCRIBED AND SWORN to before me this 1st day of February, 19 68

My commission expires March 25, 1968

Catherine Darcey
Notary Public -
Catherine Darcey Notary Public.

DRILLER'S LOG

COMPANY: Richardson & McCandless, 502 Union Center Bldg., Wichita, Ks.
 CONTRACTOR: Hellar Drilling Company, Inc., Wichita, Kansas
 LEASE: #1 O'Dell
 LOCATION: NW SW SW 8-25S-13W, Stafford County, Kansas
 COMMENCED: January 15, 1967
 COMPLETED: January 29, 1967
 CASING: Set 8 5/8" Surface Casing @ 250'/225 Sacks cement

0-158	Sand
158-811	Shale & Red Bed
811-822	Anhydrite
822-990	Shale & Red Bed
990-1500	Red Bed & Shale
1500-1825	Shale
1825-3640	Lime & Shale
3640-3747	Shale & Lime
3747-3790	Lime
3790-3880	K. C. Lime
3880-3995	Lime & Shale
3995-4063	Lime & Chert
4063-4110	Mississippi Chert
4110-4180	Chert & Lime
4180-4223	Viola Chert & Lime
4223-4296	Simpson Chert & Sand
4296-4313 1/2	Arbuckle Dolomite
4313 1/2	Rotary Total Depth

RECEIVED
 STATE CORPORATION COMMISSION
 FEB 2 - 1968
 CONSERVATION DIVISION
 Wichita, Kansas

D & A

STATE OF KANSAS)
) SS
 COUNTY OF SEDGWICK)

I, D. L. Hellar, do hereby certify that the above and foregoing is a true and correct copy of the log of the #1 O'Dell, located in NW SW SW 8-25S-13W, Stafford County, Kansas, as reflected by the files of the Hellar Drilling Company, Inc.

HELLAR DRILLING COMPANY, INC.

By *D. L. Hellar*
 President - D. L. Hellar

Subscribed and sworn to before me, a Notary Public, in and for Sedgwick County, Kansas this 1st day of February, 1968.

My Commission Expires:
 March 25, 1968.

Catherine Darcey
 Notary Public - Catherine Darcey