


STATE OF KANSAS  
STATE CORPORATION COMMISSION

Give All Information Completely  
Make Required Affidavit  
Mail or Deliver Report to:  
Conservation Division  
State Corporation Commission  
800 Bittling Building  
Wichita, Kansas

WELL PLUGGING RECORD

NORTH

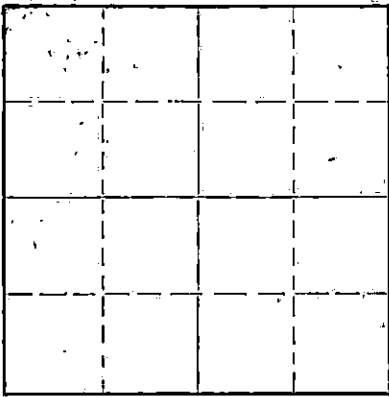

Locate well correctly on above  
Section Plat

Stafford County, Sec. 7 Twp. 25 Rge. 13 (E) 13 (W)  
Location as "NE/CNW 1/4 SW 1/4" or footage from lines SE SE SW  
Lease Owner J. M. Huber Corp.  
Lease Name Kachelman B #1 Well No.  
Office Address 916 S. Pine - Pratt, Kansas  
Character of Well (completed as Oil, Gas or Dry Hole) Oil  
Date well completed 8-2-50 19  
Application for plugging filed 3-29-51 19  
Application for plugging approved 3-30-51 19  
Plugging commenced 3-31-51 19  
Plugging completed 4-6-51 19  
Reason for abandonment of well or producing formation  
Not profitable to Produce  
If a producing well is abandoned, date of last production Jan. 25, 1951 19  
Was permission obtained from the Conservation Division or its agents before plugging was commenced? Yes

Name of Conservation Agent who supervised plugging of this well Mr. C. D. Stough  
Producing formation Depth to top Bottom Total Depth of Well 1315 Feet  
Show depth and thickness of all water, oil and gas formations.

OIL, GAS OR WATER RECORDS

CASING RECORD

Formation	Content	From	To	Size	Put In	Pulled Out
				8 5/8"	395'	None
				5 1/2"	1407.5'	2122'

Describe in detail the manner in which the well was plugged, indicating where the mud fluid was placed and the method or methods used in introducing it into the hole. If cement or other plugs were used, state the character of same and depth placed, from feet to feet for each plug set.

Set fresh water plug at 250' and cemented w/15 sacks. Mudded hole to 30' and cemented w/10 sacks.

RECEIVED  
STATE CORPORATION COMMISSION

APR 14 1951

CONSERVATION DIVISION

Correspondence regarding this well should be addressed to J. M. Huber Corp. Kansas  
Address P. O. Box 460  
Pratt, Kansas

STATE OF KANSAS, COUNTY OF PRATT, ss.  
(employee of owner) or (owner or operator) of the above-described well,  
being first duly sworn on oath, says: That I have knowledge of the facts, statements, and matters herein contained and the log of the above-described well as filed and that the same are true and correct. So help me God.

(Signature)

(Address)

SUBSCRIBED AND SWORN to before me this 13th day of April, 1951

My commission expires August 20, 1951

PLUGGING  
FILE SEC-7 TOS R13w  
BOOK PAGE 72 LINE 19

J. R. Kelly  
Notary Public.