


STATE OF KANSAS  
STATE CORPORATION COMMISSION

WELL PLUGGING RECORD

Give All Information Completely  
Make Required Affidavit  
Mail or Deliver Report to  
Conservation Division  
State Corporation Comm.  
245 North Water  
Wichita, KS 67202

Stafford County. Sec. 7 Twp. 25S Rge. 13W E/W  
Location as "NE/CNW $\frac{1}{4}$ /SW $\frac{1}{4}$ " or footage from lines  
SE SW NE

Lease Owner The Maurice L. Brown Co.  
Lease Name CURTIS Well No. 3  
Office Address 1500 Vickers KSB&T Bldg, Wichita, Kansas 67202  
Character of Well (Completed as Oil, Gas or Dry Hole)  
Dry Hole

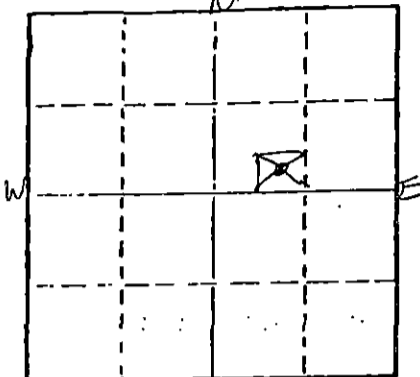

Date Well completed 3-06 19 77  
Application for plugging filed (Verbally) 3-06 19 77  
Application for plugging approved (Verbally) 3-06 19 77  
Plugging commenced 3-06 19 77  
Plugging completed 3-06 19 77

Reason for abandonment of well or producing formation  
No commercial quantity of oil or gas encountered  
If a producing well is abandoned, date of last production  
19

Was permission obtained from the Conservation Division or  
its agents before plugging was commenced? Yes

Name of Conservation Agent who supervised plugging of this well J. H. Melts  
Producing formation Depth to top Bottom Total Depth of Well  
Show depth and thickness of all water, oil and gas formations.

OIL, GAS OR WATER RECORDS

CASING RECORD

FORMATION	CONTENT	FROM	TO	SIZE	PUT IN	PULLED OUT

Describe in detail the manner in which the well was plugged, indicating where the mud fluid was placed and the method or methods used in introducing it into the hold. If cement or other plugs were used, state the character of same and depth placed, from feet to feet for each plug set.

T.D. 4000',  
Set 1st plug at 360' with 35 sx.,  
40' solid bridge with 15 sx.  
5 sx. in rathole.

RECEIVED  
STATE CORPORATION COMMISSION

MAR 17 1977

Plug was down at 2:30 p.m. 3-06-77  
State Plugger - J. H. Melts

CONSERVATION DIVISION  
Wichita, Kansas

(If additional description is necessary, use BACK of this sheet)

Name of Plugging Contractor Abercrombie Drilling, Inc.

STATE OF Kansas COUNTY OF Sedgwick ss.  
Jack L. Partridge, Asst. Sec.-Treas.

(employee of owner) or (owner or operator) of the above-described well, being first duly sworn on oath, says: That I have knowledge of the facts, statements, and matters herein contained and the log of the above-described well as filed and that the same are true and correct. So help me God.

(Signature) Jack L. Partridge  
801 Union Center, Wichita, Kansas 67202  
(Address)

SUBSCRIBED AND SWORN TO before me this 14th day of March, 19 77

My commission expires

Kathy S. Goertz  
Kathy S. Goertz Notary Public.



CONTRACTOR'S WELL LOG

OPERATOR: The Maurice L. Brown Co.  
 CONTRACTOR: Abercrombie Drilling, Inc.  
 WELL NAME: CURTIS #3  
 LOCATION: SE SW NE, Section 7-25S-13W  
 Stafford County, Kansas  
 SPUD DATE: 2-23-77  
 COMPLETION DATE: 3-06-77

0	165	Sand & Surface Clay
165	830	Shale
830	1617	Sand & Shale
1617	1924	Shale & Lime
1924	2135	Lime & Shale
2135	2505	Shale & Lime
2505	2730	Lime & Shale
2730	3055	Shale & Lime
3055	3315	Lime & Shale
3315	3535	Shale & Lime
3535	3868	Lime
3868	3910	Lime & Shale
3910	4000	Lime
	4000	Rotary Total Depth

Spud hole at 8:45 p.m. 2-23-77. Drilled 383' of 12 1/4" hole. Ran 9 jts. of 8 5/8" surface pipe (Tally 365.22') Set at 273.73'. Cemented with 125 sx. of Halliburton Lite, 3% Ca. Cl., 1/4# Floccel per sack, followed with 150 sx. Halliburton heavy, 3% Ca. Cl., 1/4# Floccel per sack. Plug was down at 4:45 a.m. 2-24-77. Cement did circulate.

T.D. 4000', Preparing to plug, laying down drill pipe. Set 1st plug at 360' with 35 sx., 40' solid bridge with 15 sx., 5 sx. in rathole. Plug was down at 2:30 p.m. 3-06-77. State Plugger - J. H. Melts.

STATE OF KANSAS )  
 ) SS  
 COUNTY OF SEDGWICK )

RECEIVED  
 STATE CORPORATION COMMISSION

MAR 17 1977

CONSERVATION DIVISION  
 Wichita, Kansas

Jack L. Partridge, Assistant Secretary-Treasurer of Abercrombie Drilling, Inc., does hereby state that the following is a true and correct log of the CURTIS #3, SE SW NE, Section 7-25S-13W, Stafford County, Kansas.

ABERCROMBIE DRILLING, INC.

BY Jack L. Partridge  
 Jack L. Partridge, Asst. Sec.-Treas.

Subscribed and sworn to before me, a Notary Public, in and for the aforesaid county and state as of this 14th day of March, 1977.



Kathy S. Goertz  
 Kathy S. Goertz, Notary Public